



REAR LEFT SIDE PERSPECTIVE VIEW W/ KIOSK DOORS OPEN

SCALE: NTS

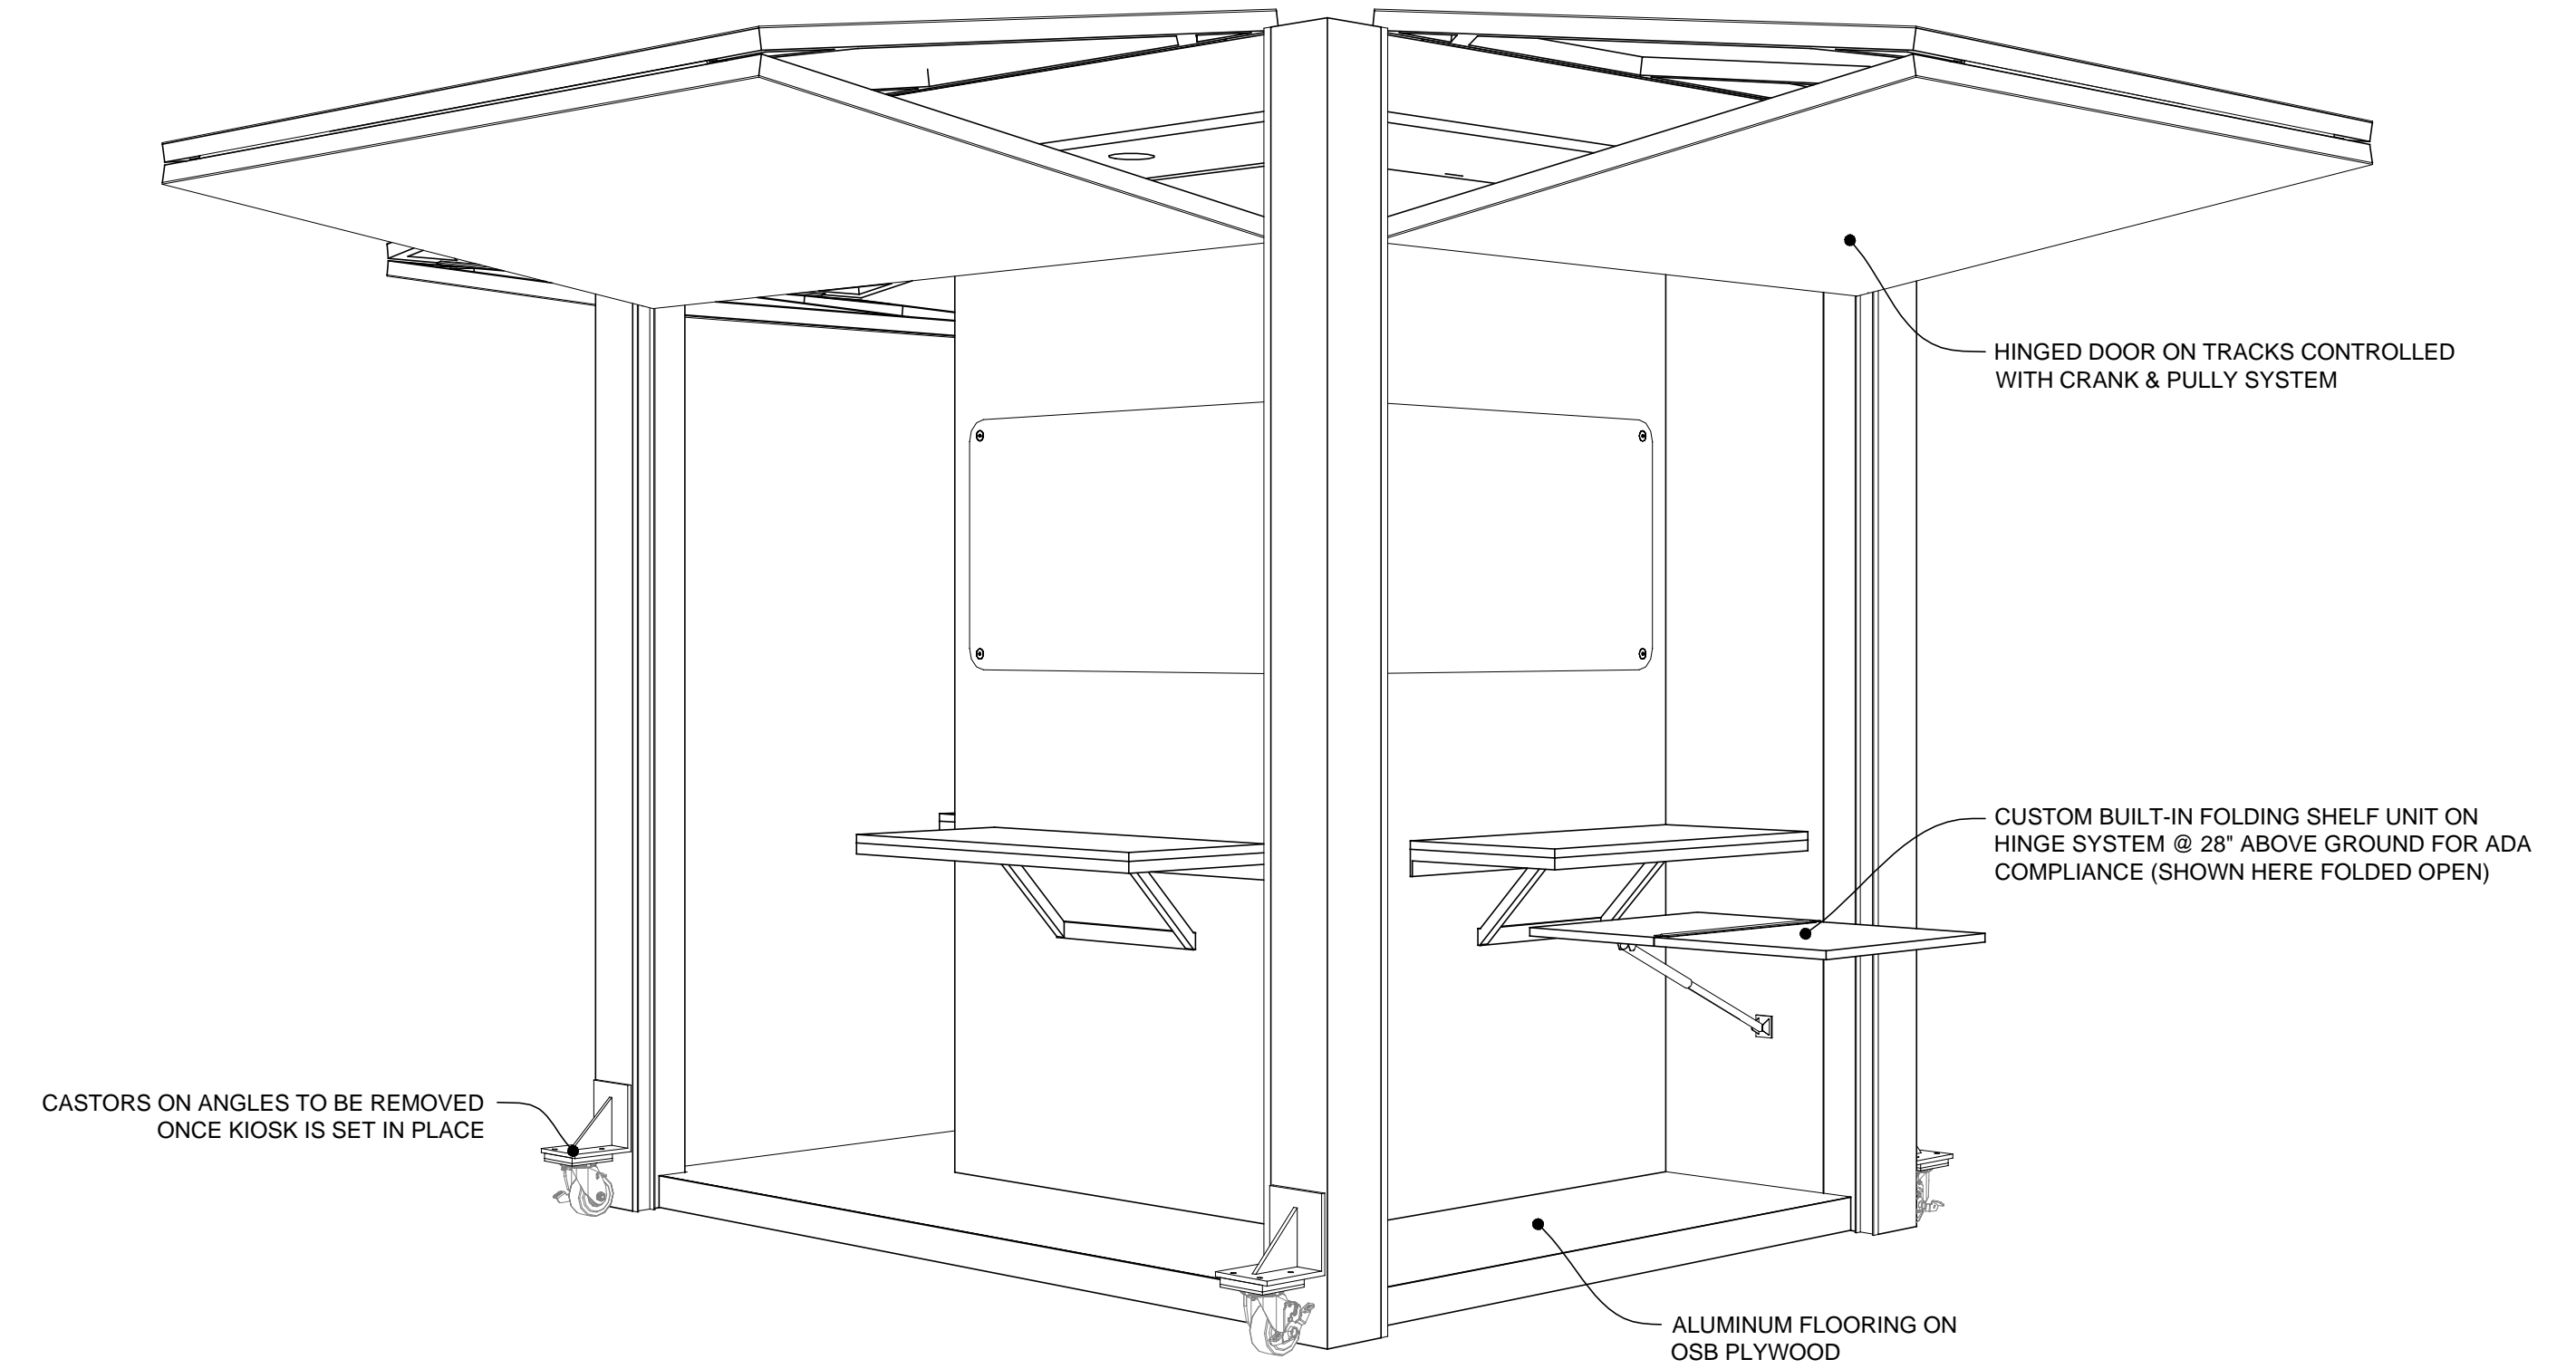


FRONT RIGHT SIDE PERSPECTIVE VIEW W/ KIOSK DOORS OPEN

SCALE: NTS

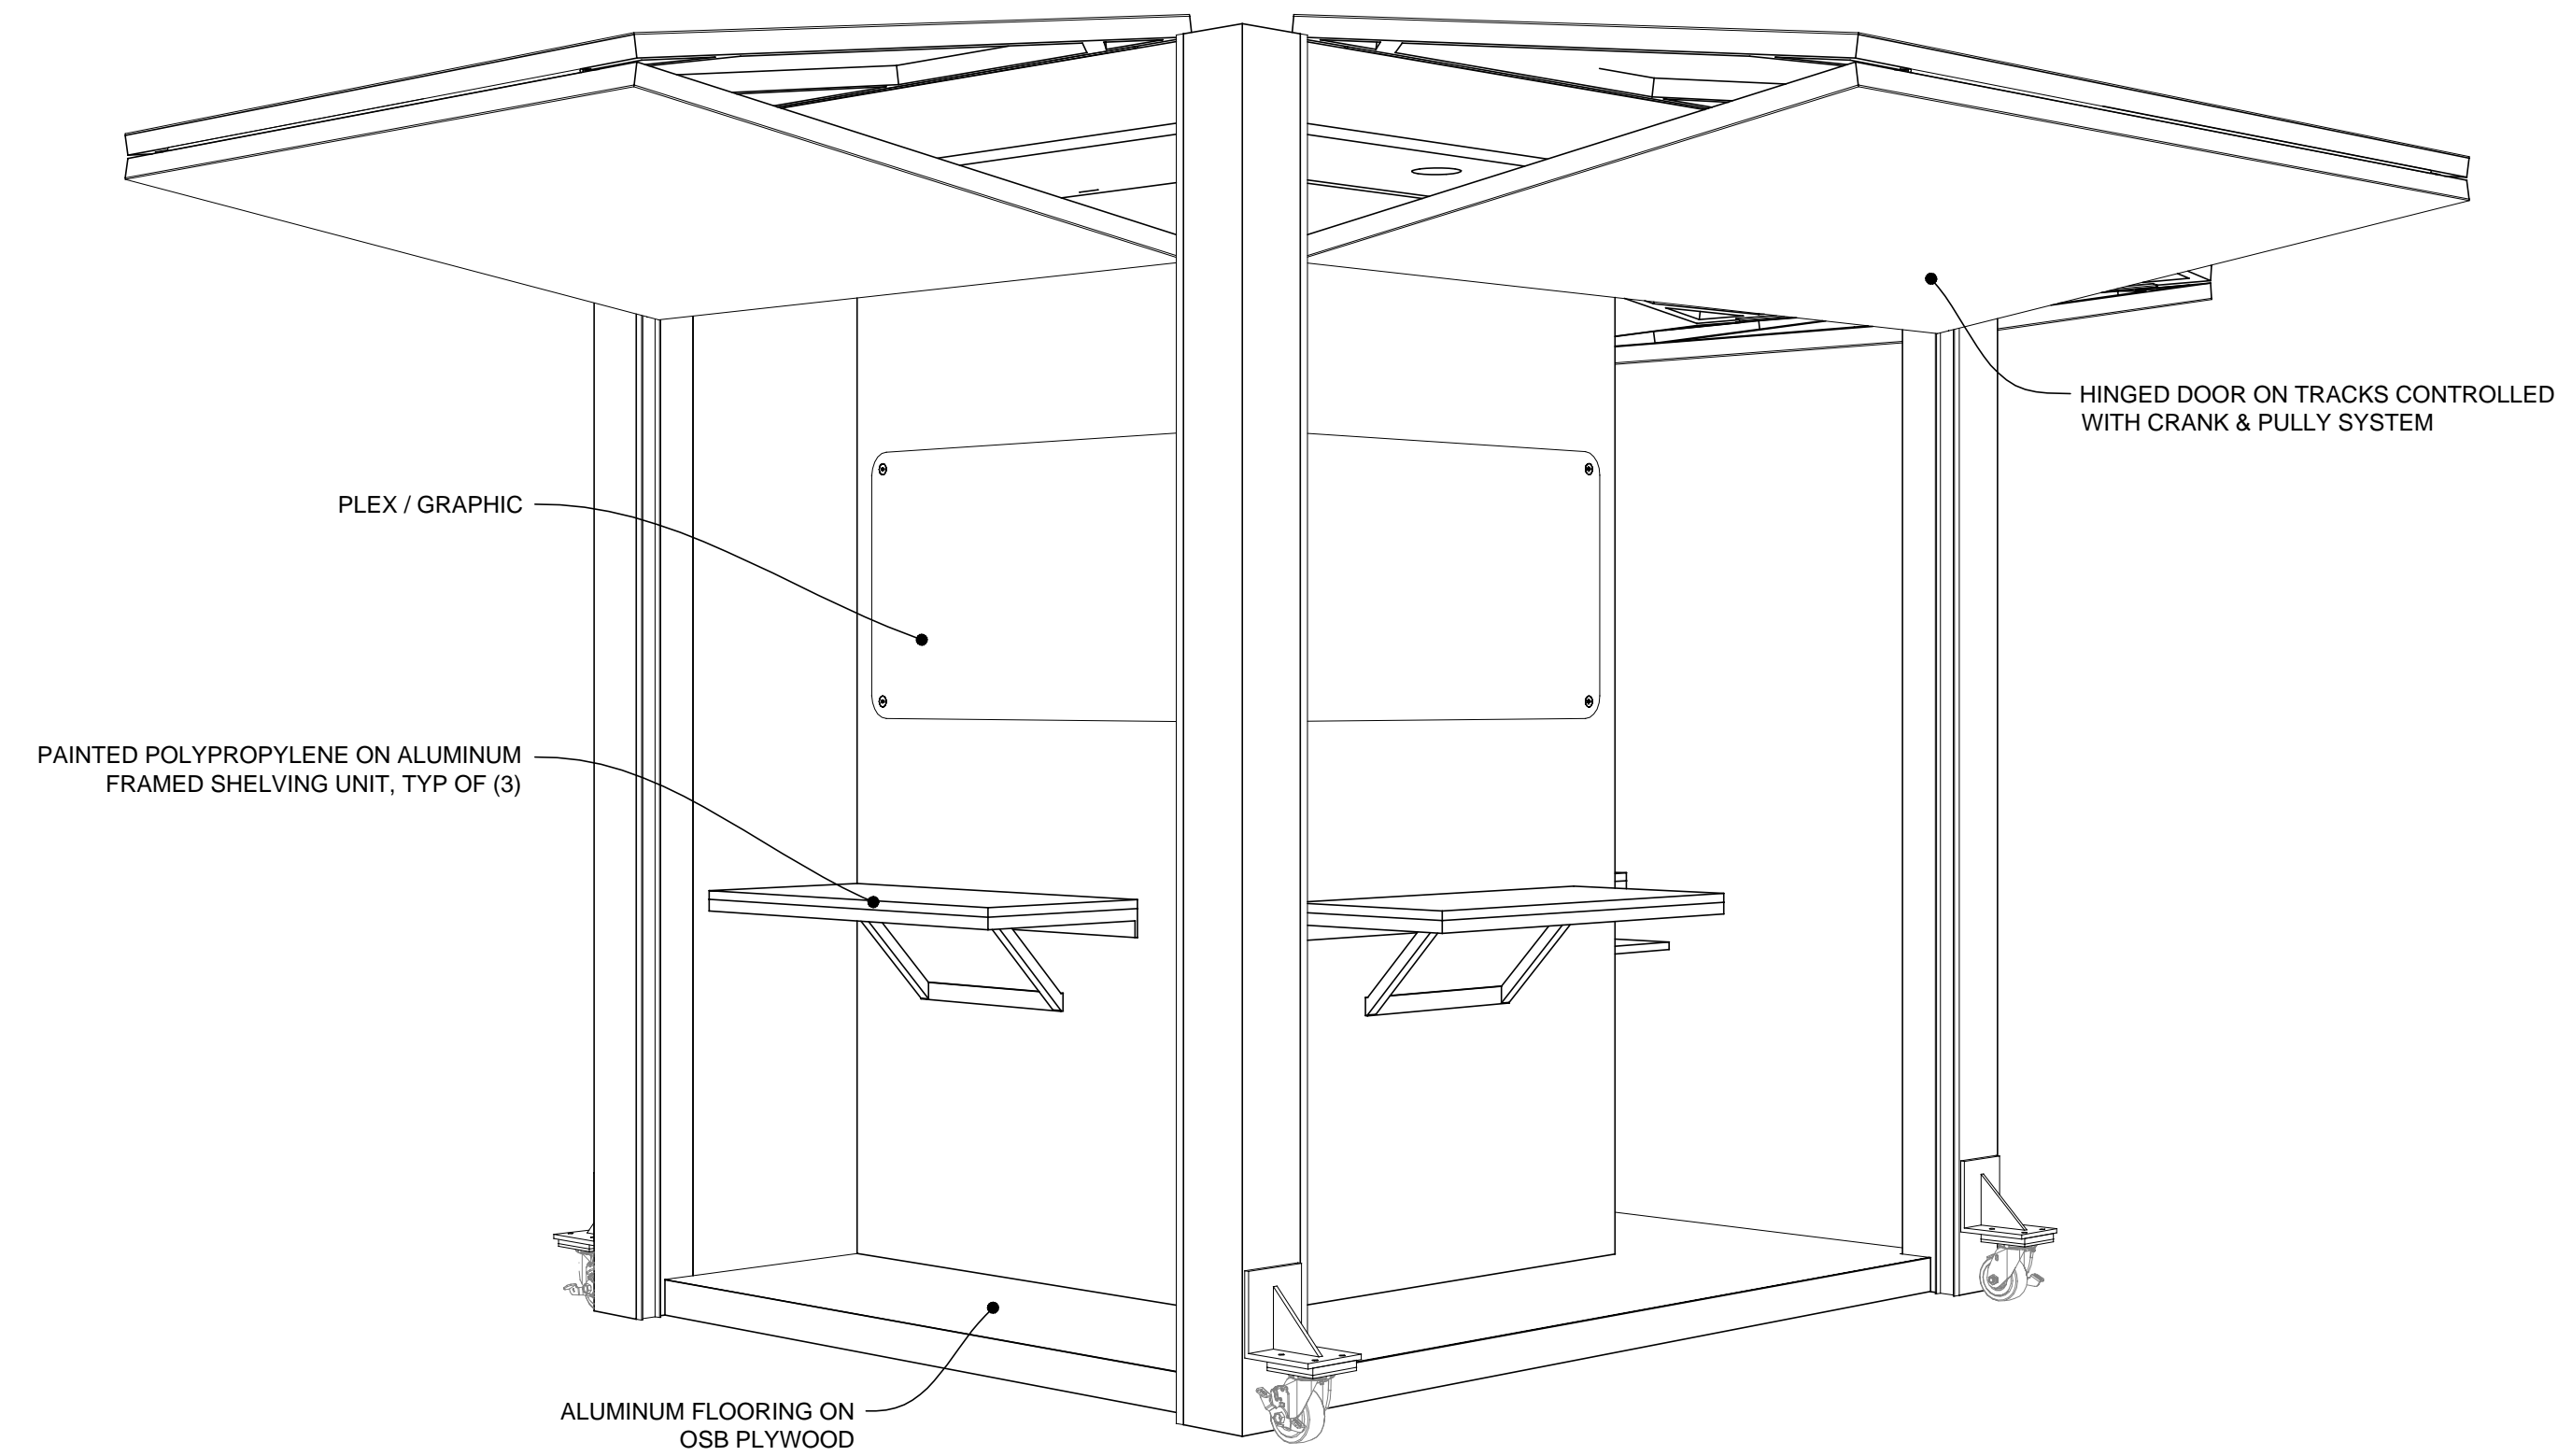

FRONT LEFT PERSPECTIVE VIEW W/ KIOSK DOORS OPEN

SCALE: NTS

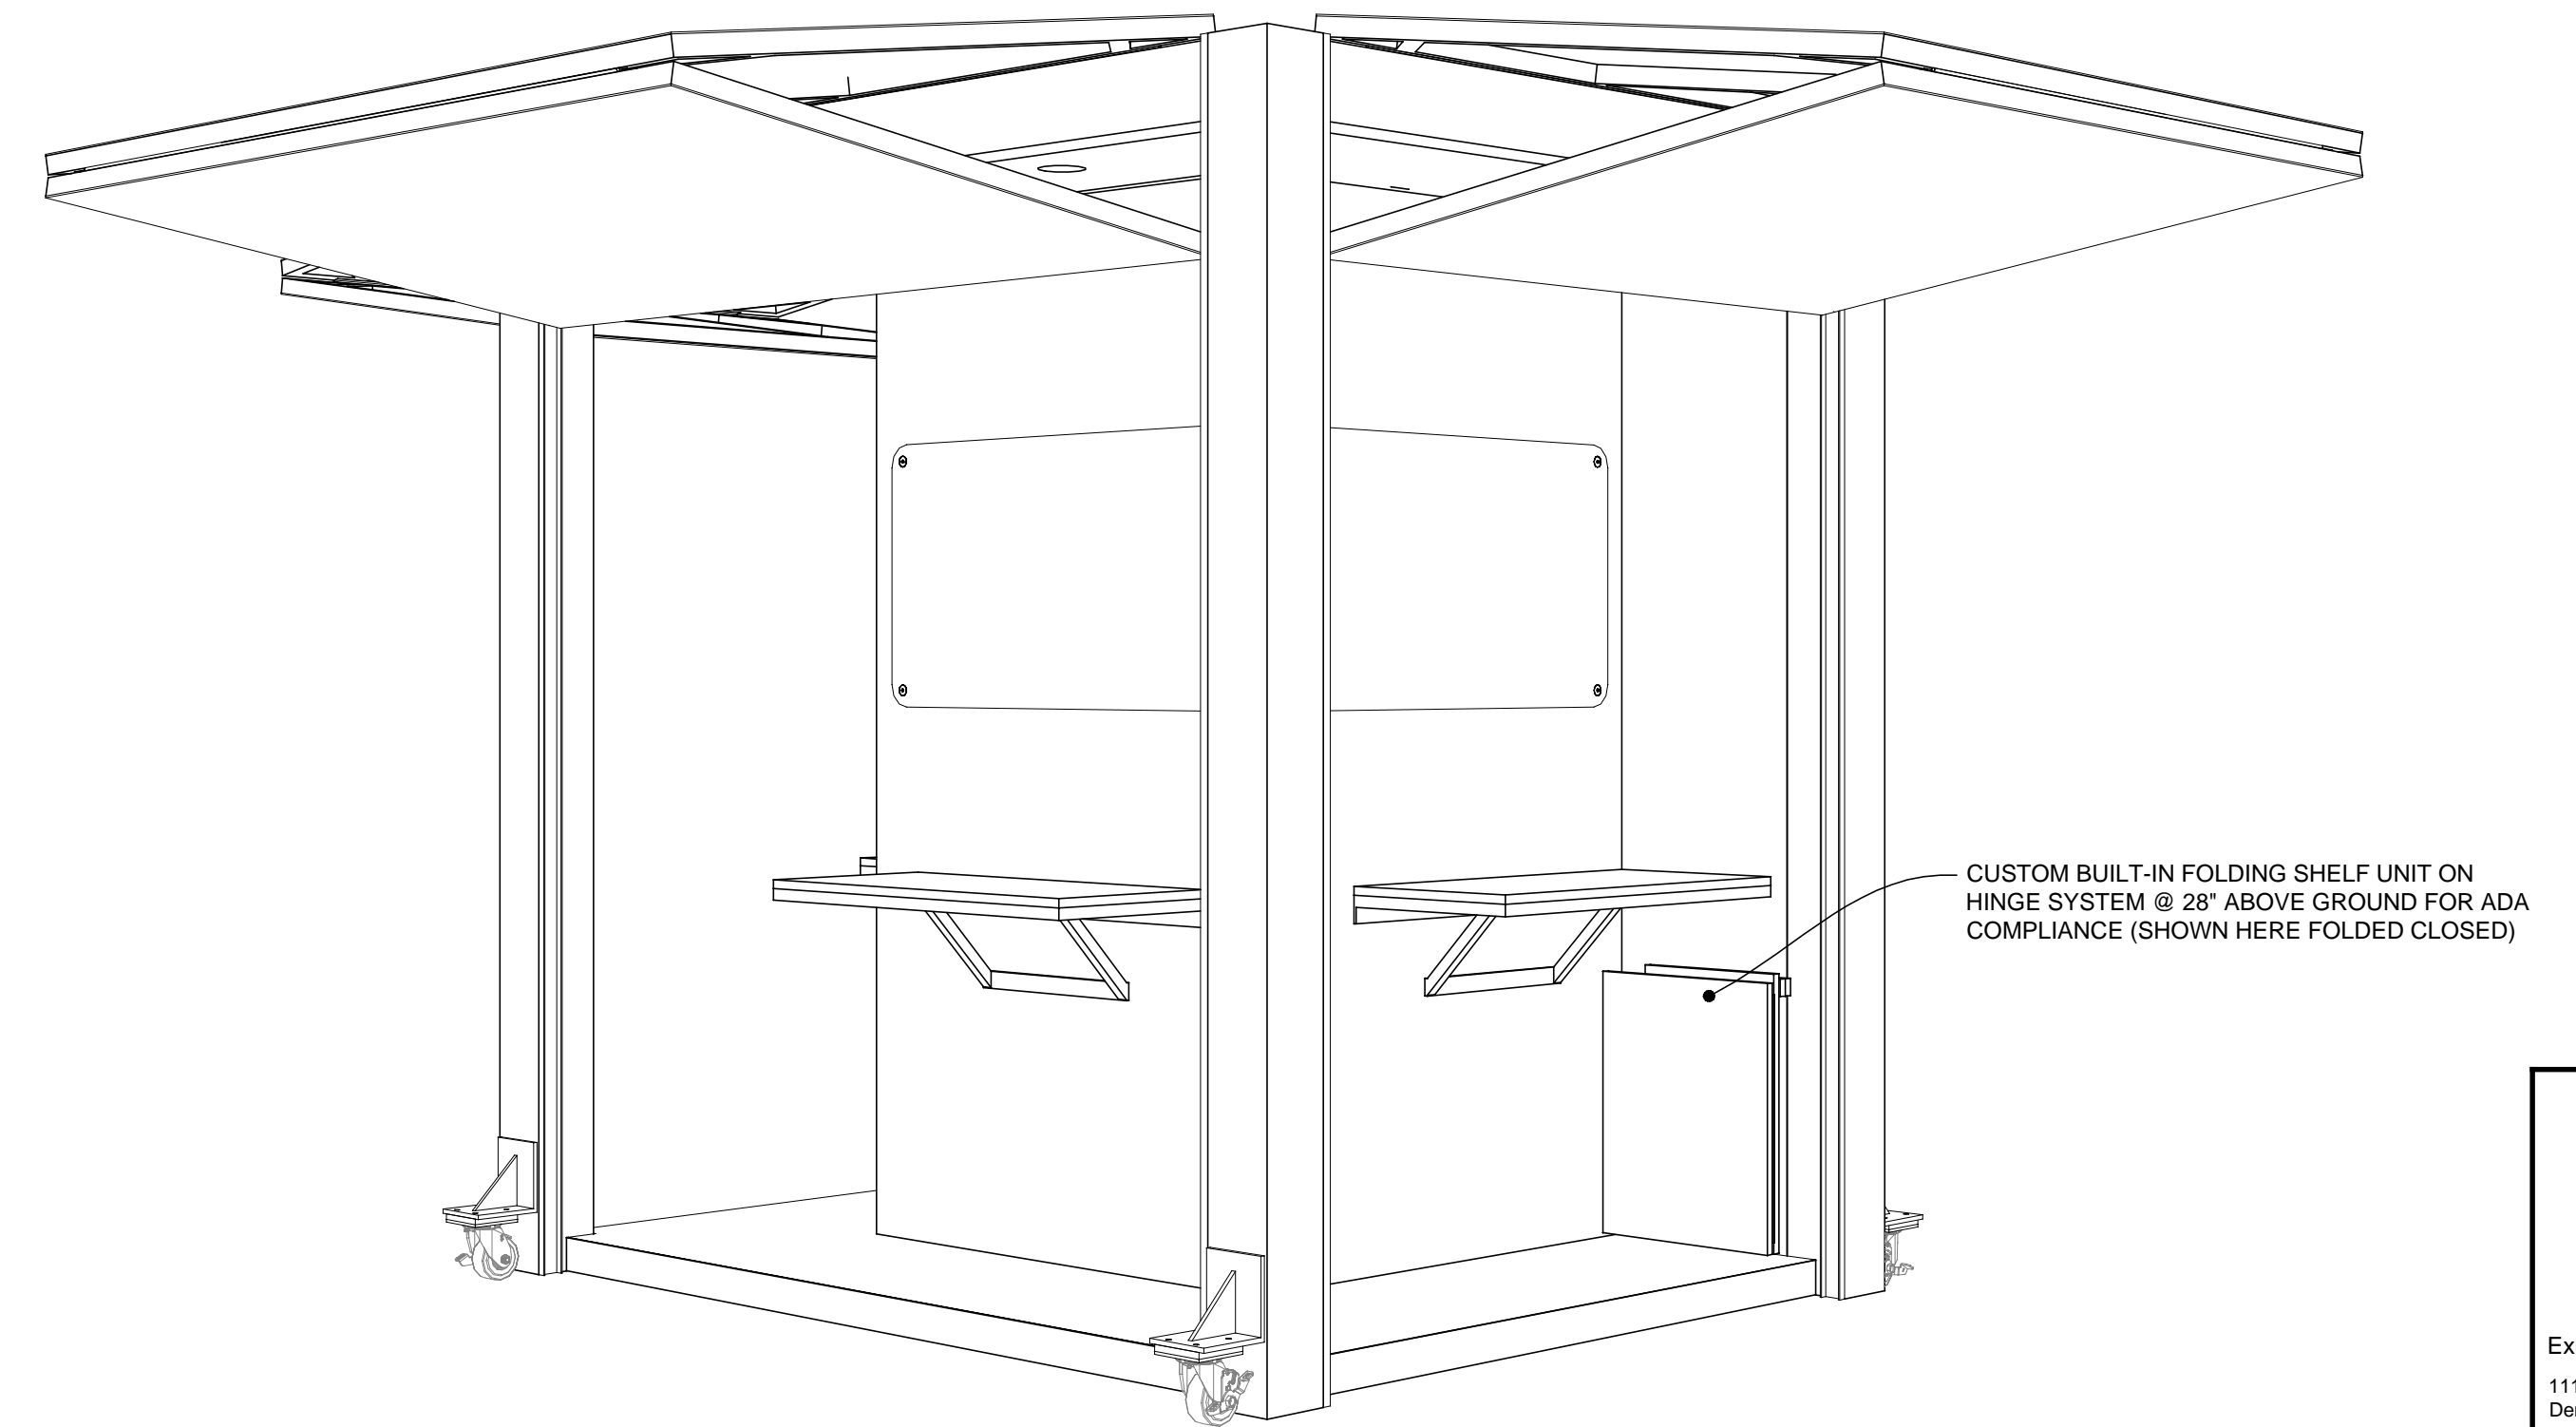

FRONT RIGHT SIDE PERSPECTIVE VIEW W/ KIOSK DOORS OPEN

SCALE: NTS

Czarnowski
We love what we do.

Exhibit Services | Strategic Services | Event Services
11175 East 55th Avenue, Suite 100 Phone: 303.371.3344
Denver, CO 80239 Fax: 303.371.3437

Copyright © 2013 Czarnowski
The contents of this document are the property of Czarnowski and may not be reproduced, distributed, transmitted, displayed, or published without the prior written permission of Czarnowski.

PROJ. MGR.	DR	DESIGNER	MO	DETAILER	PDL
------------	----	----------	----	----------	-----

CREATION DATE	03.19.2013	ISSUE DATE	-	RELEASE DATE	-
---------------	------------	------------	---	--------------	---


CLIENT NAME
AMERICAN EXPRESS

ELEMENT NAME
UNIVERSAL STUDIOS KIOSK


DRAWING TITLE
PERSPECTIVE VIEW -- AS-BUILT DRAWINGS

CLIENT CODE	PROJECT NO.	SHEET
-------------	-------------	-------

AMEX 130001 1.0

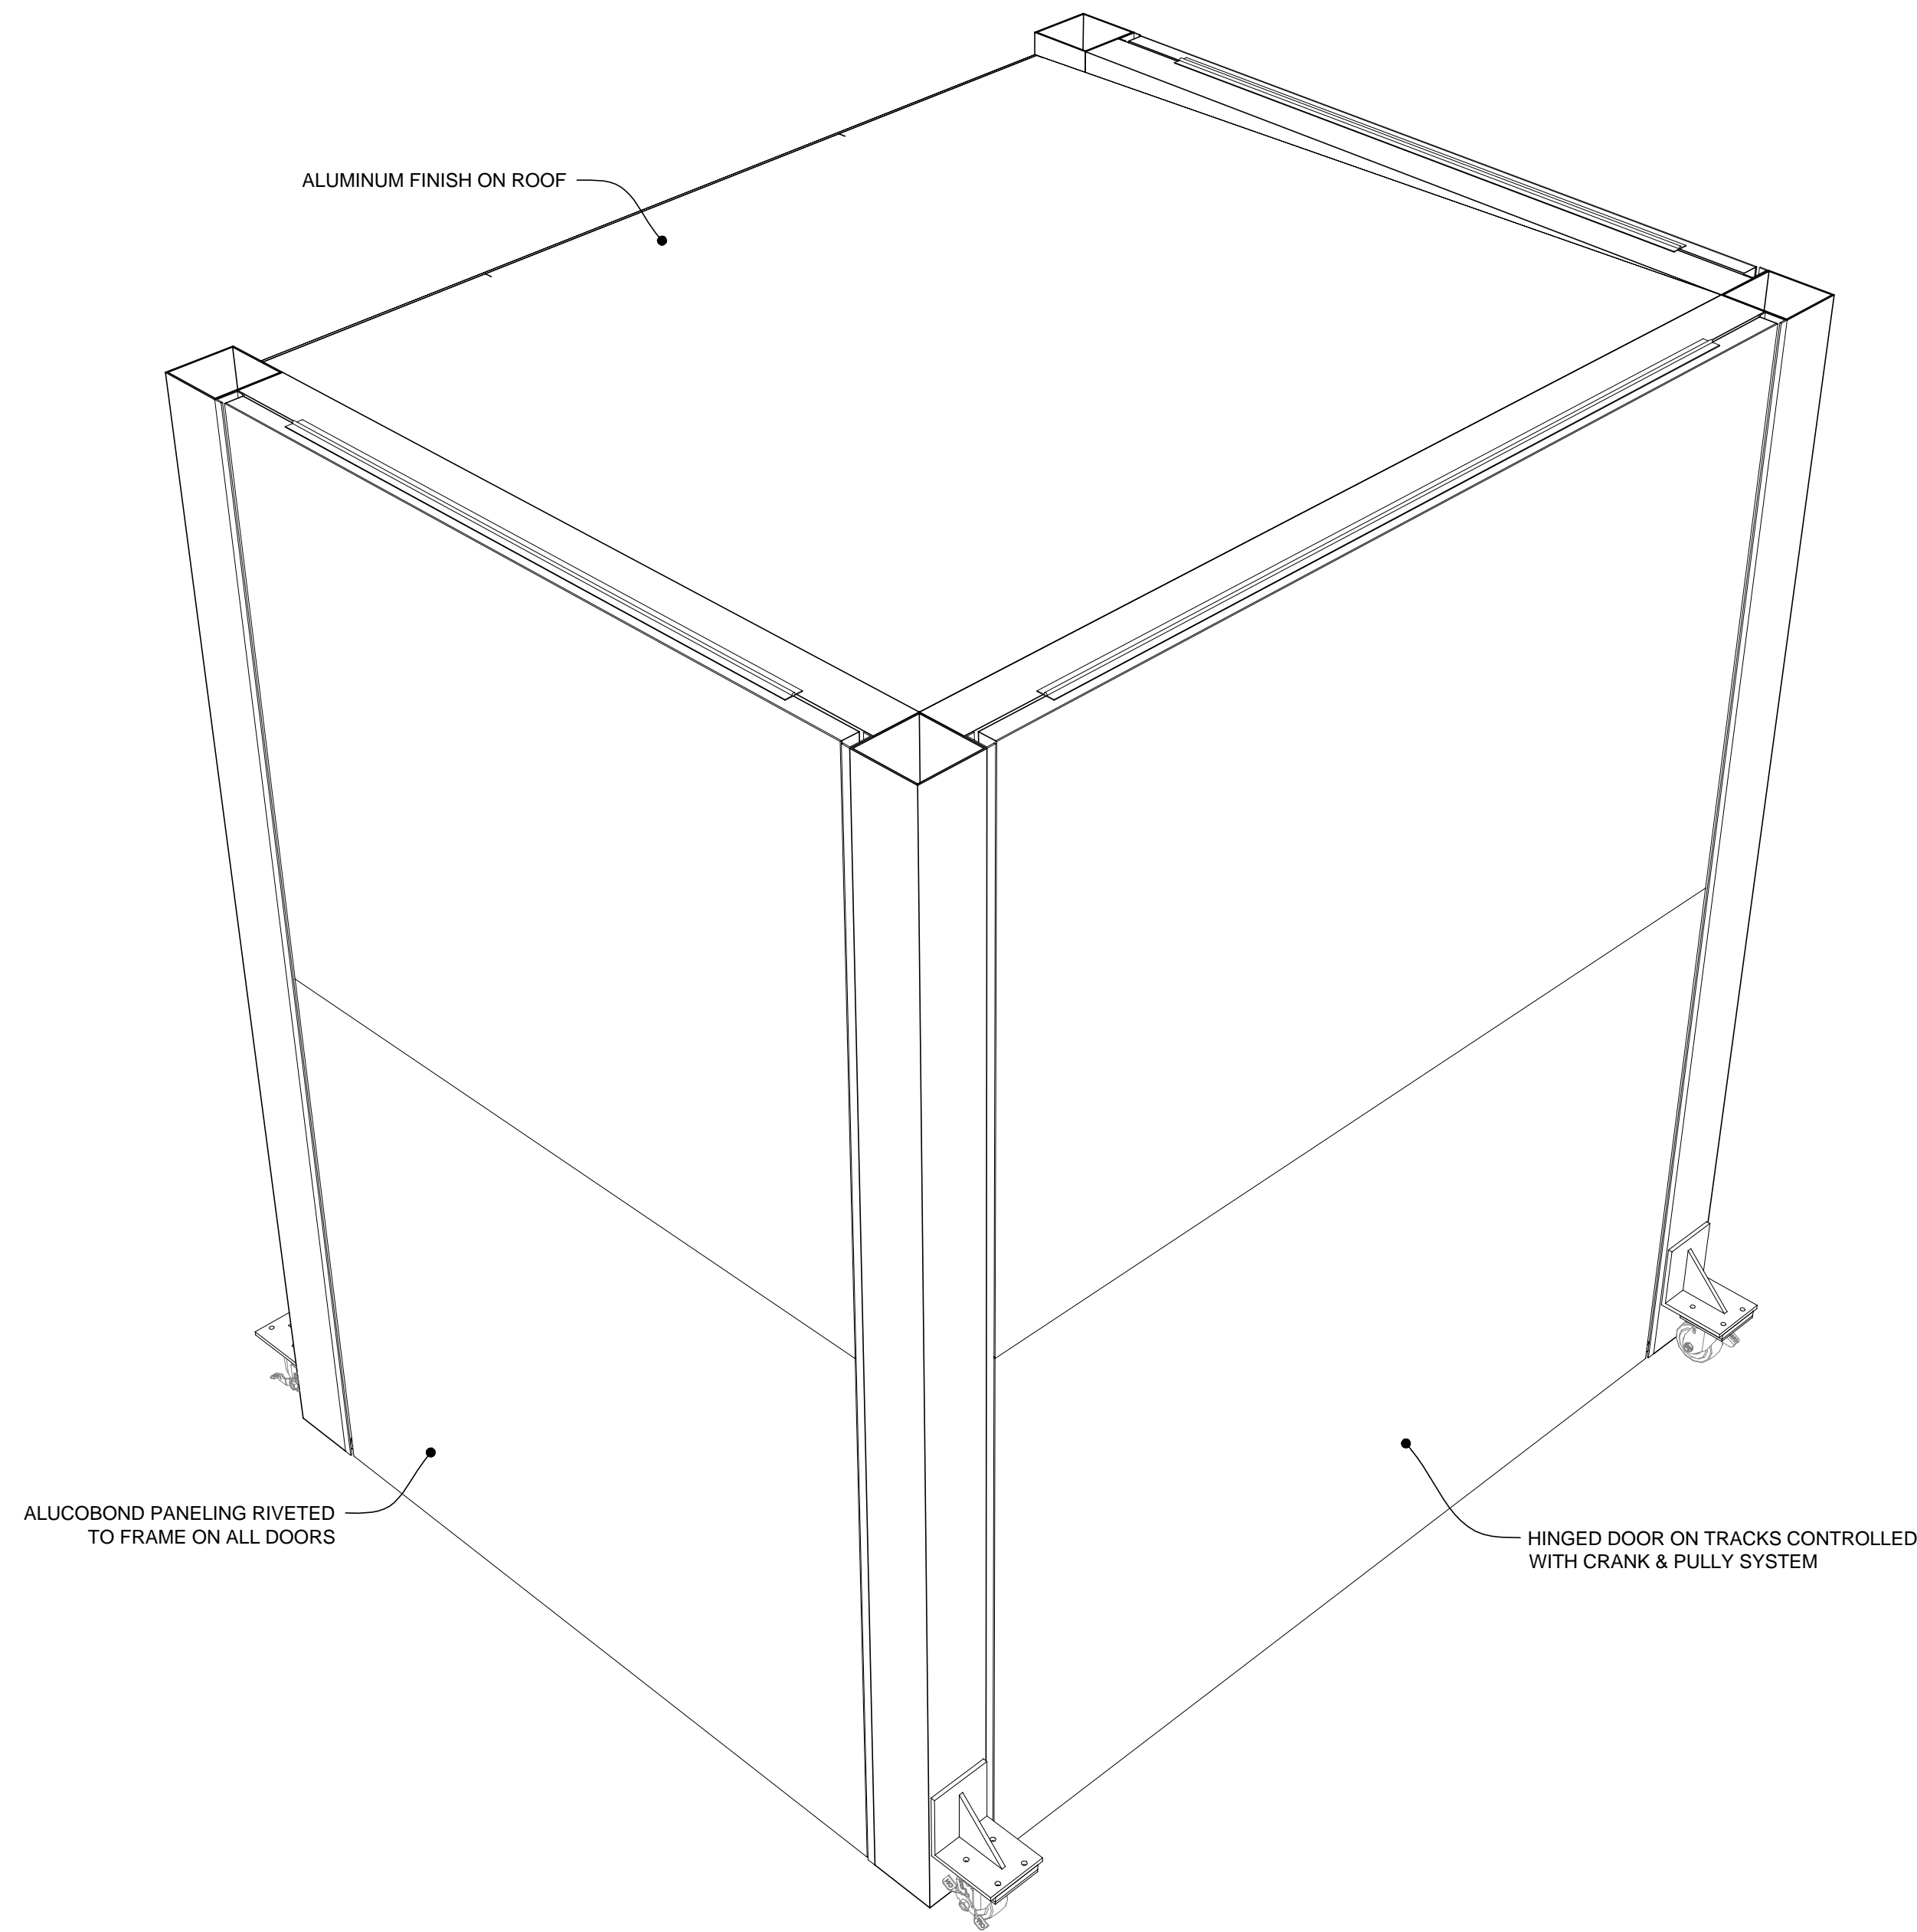

FRONT LEFT SIDE PERSPECTIVE VIEW W/ KIOSK DOORS CLOSED
SCALE: NTS

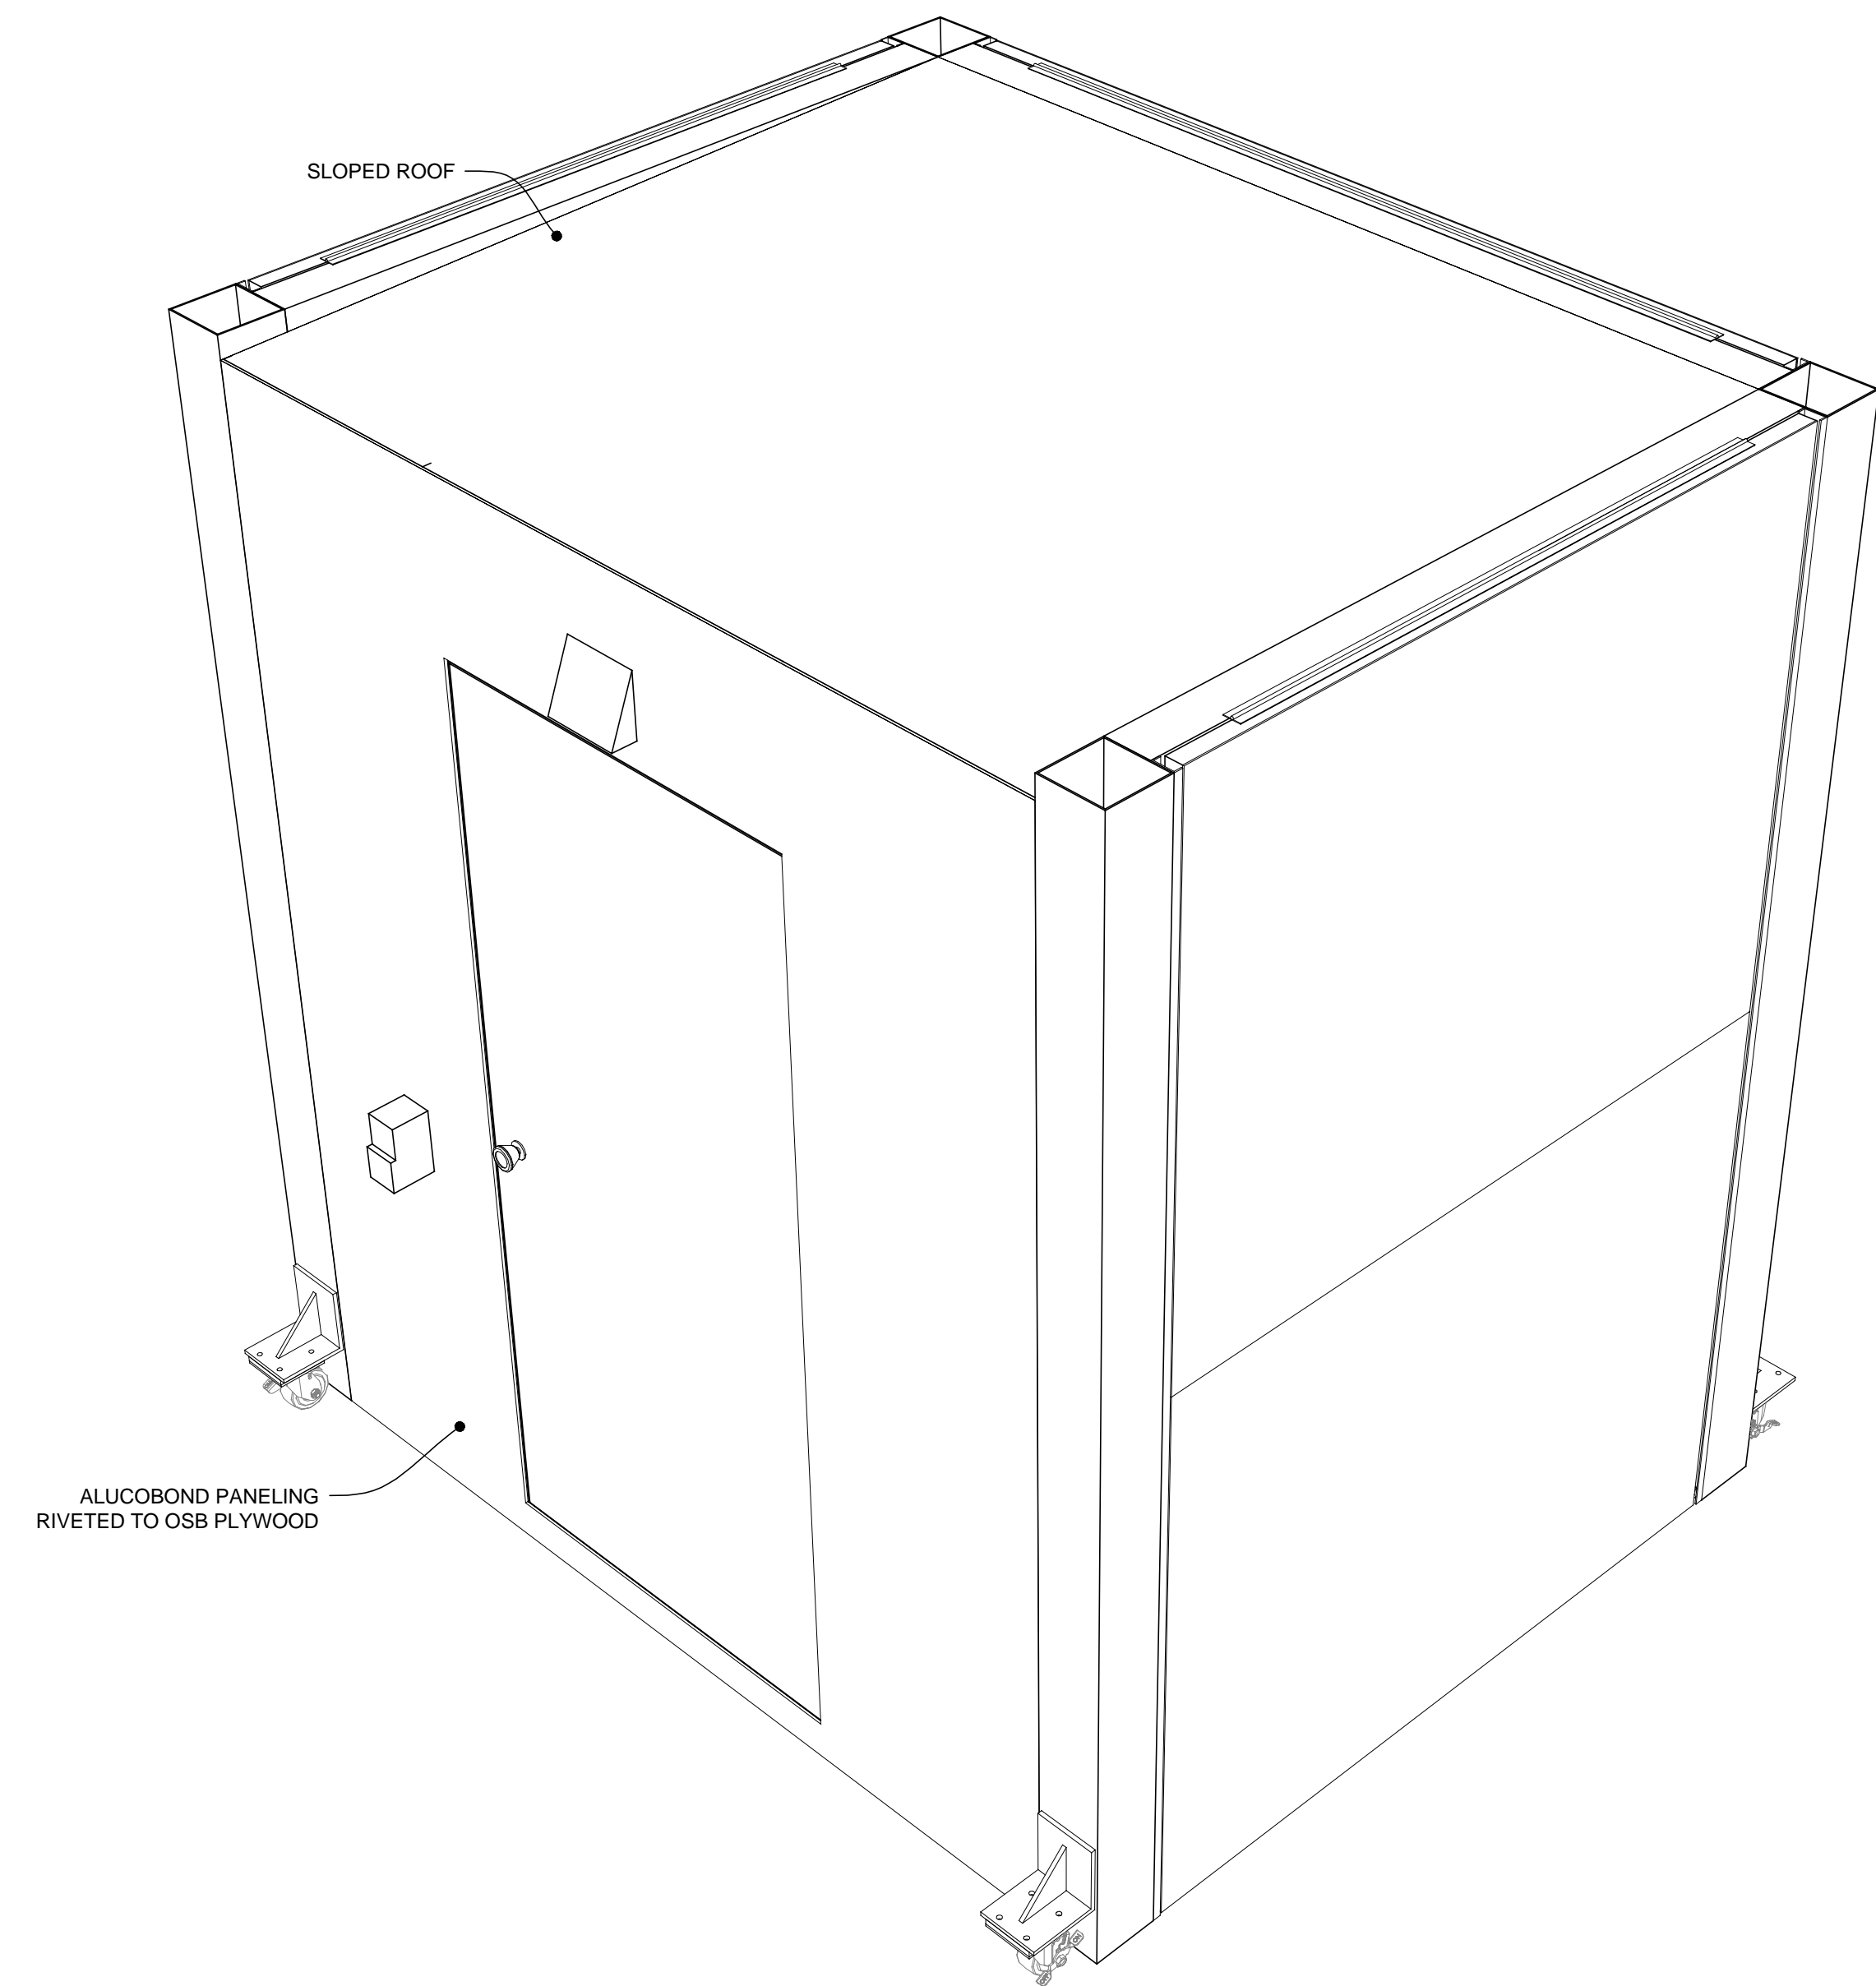

REAR RIGHT SIDE PERSPECTIVE VIEW W/ KIOSK DOORS CLOSED
SCALE: NTS


Czarnowski
We love what we do.

Exhibit Services | Strategic Services | Event Services
11175 East 55th Avenue, Suite 100 Phone: 303.371.3344
Denver, CO 80239 Fax: 303.371.3437

Copyright © 2013 Czarnowski
The contents of this document are the property of Czarnowski and may not be reproduced, distributed, transmitted, displayed, or published without the prior written permission of Czarnowski.


PROJ. MGR.	DESIGNER	DETAILER
DR	MO	PDL
CREATION DATE	ISSUE DATE	RELEASE DATE
03.19.2013	-	-
CLIENT NAME		
AMERICAN EXPRESS		
ELEMENT NAME		
UNIVERSAL STUDIOS KIOSK		
DRAWING TITLE		
PERSPECTIVE VIEW -- AS-BUILT DRAWINGS		
CLIENT CODE	PROJECT NO.	SHEET

AMEX 130001 1.1

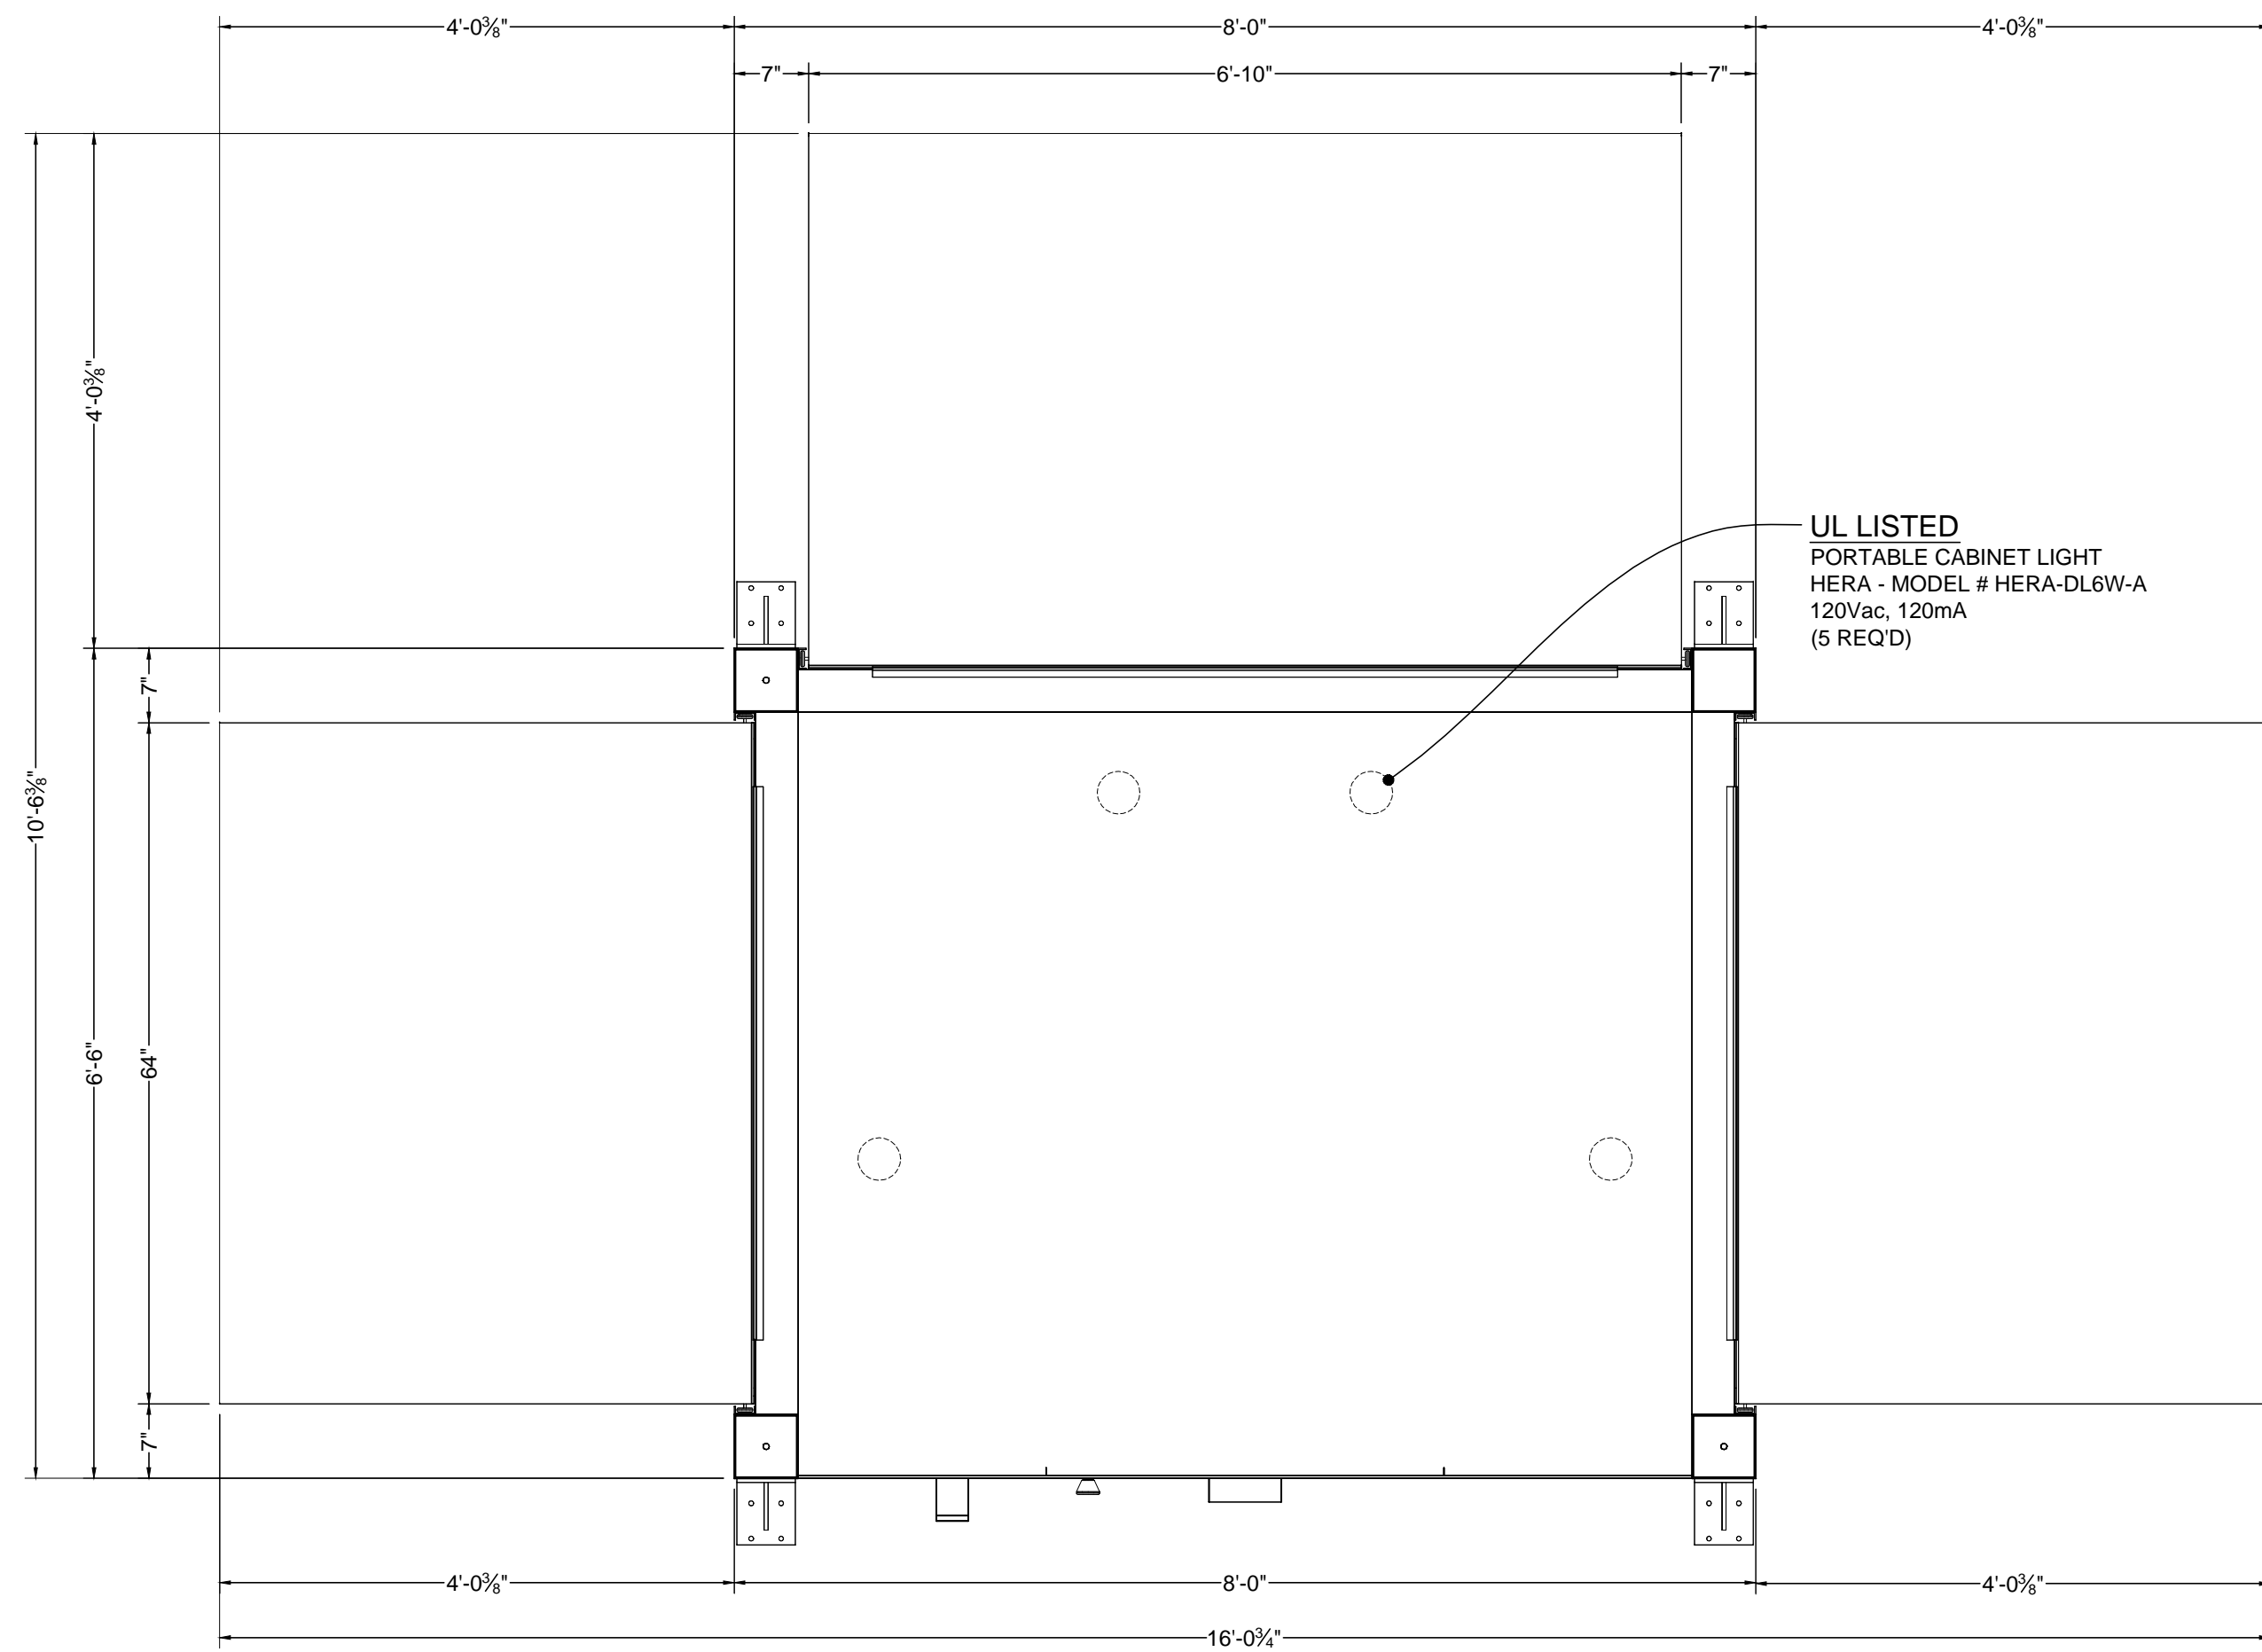


PLAN VIEW - KIOSK WITH DOORS OPEN

SCALE: 3/4" = 1'-0"

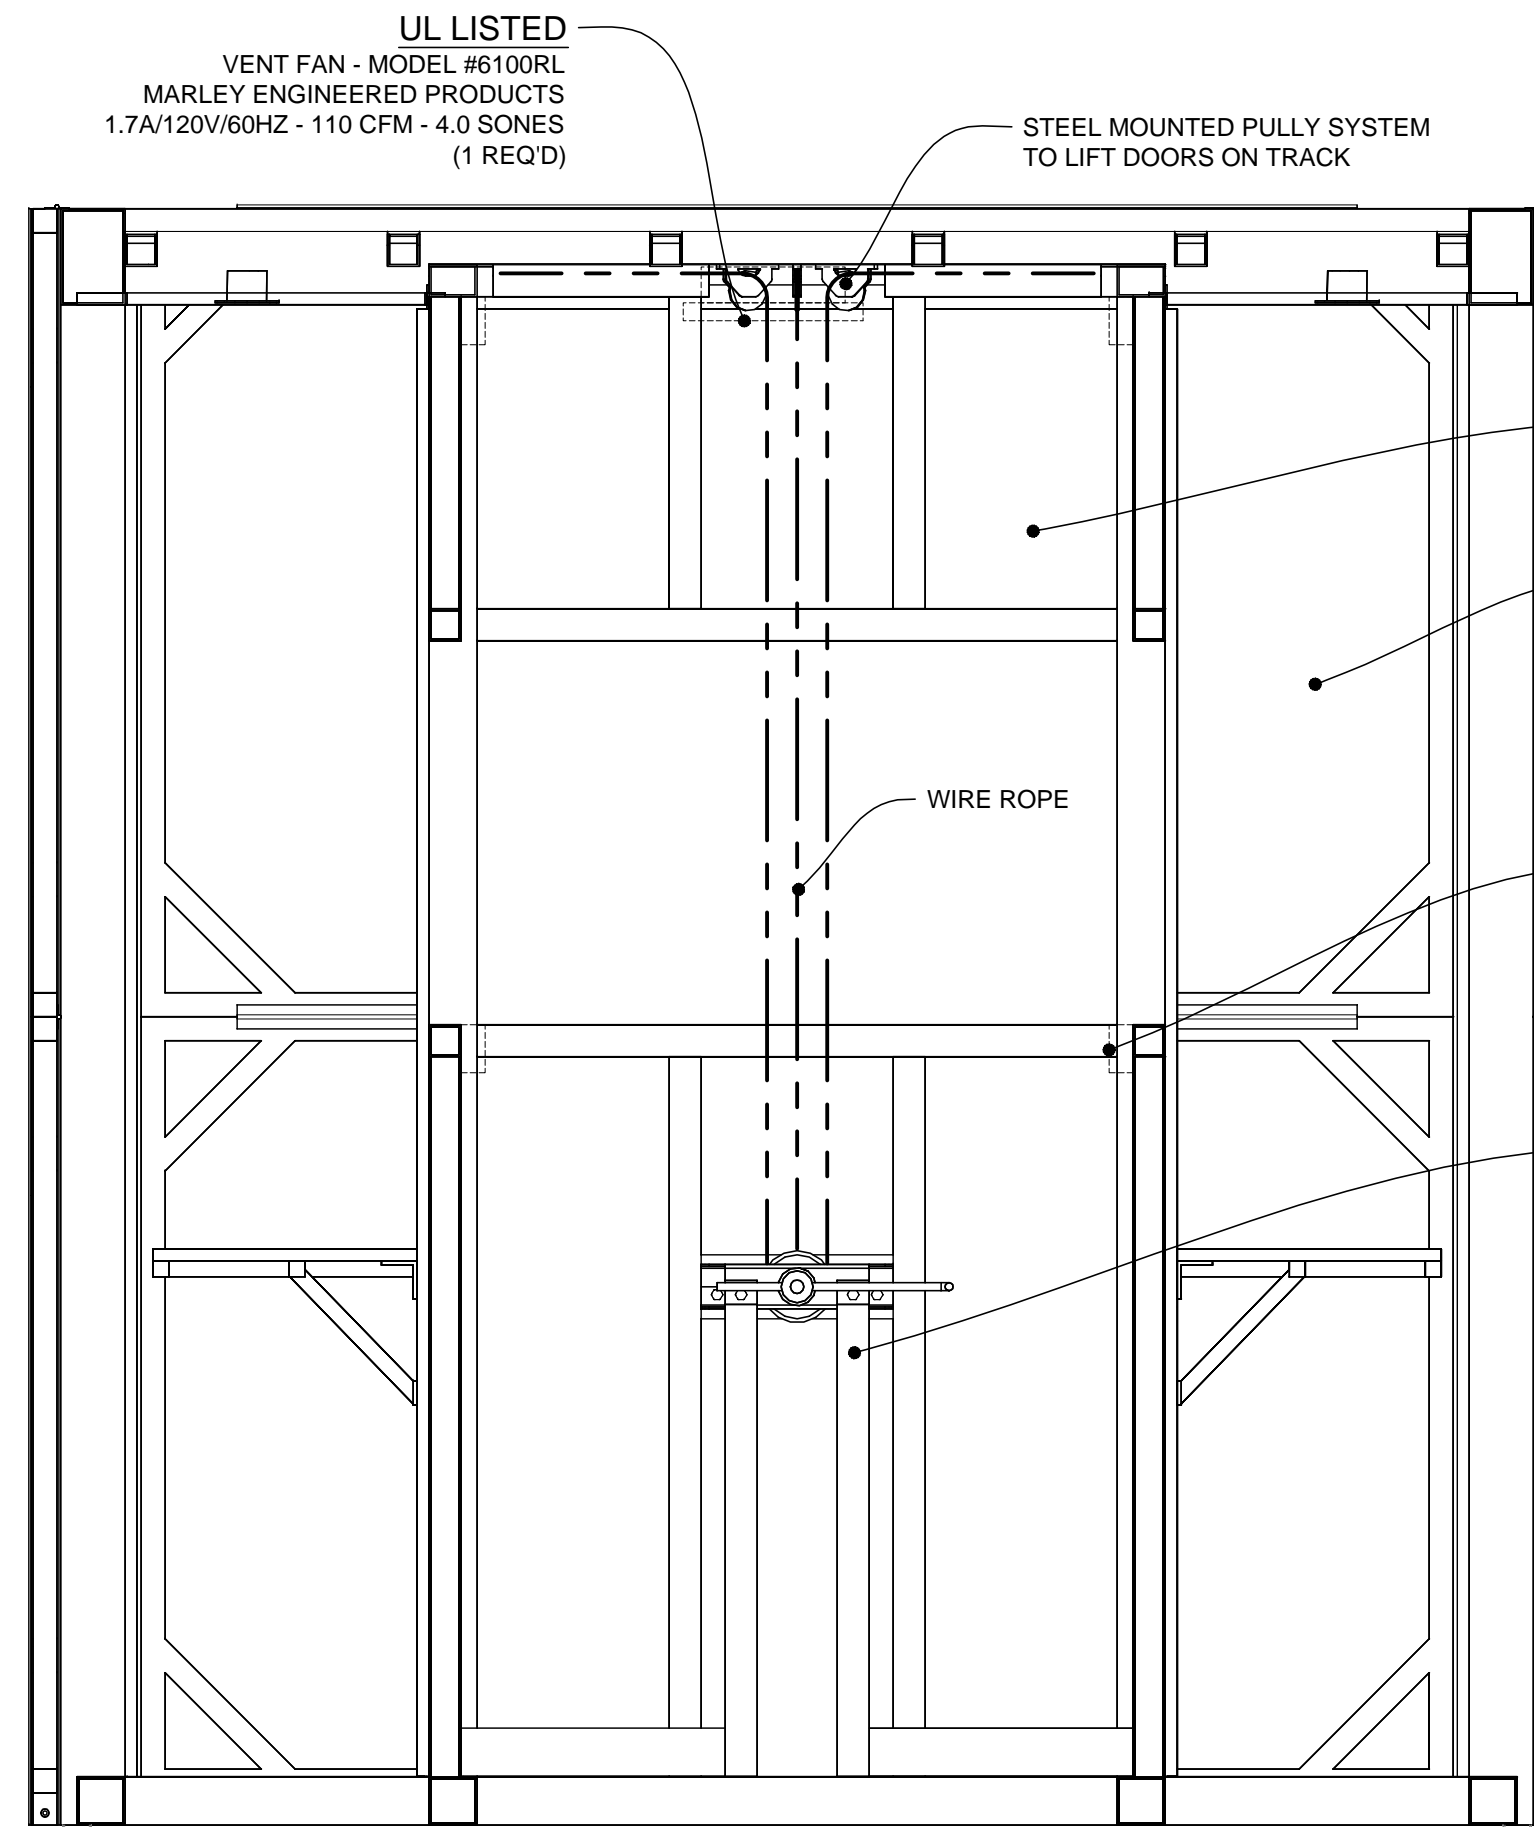

SECTION VIEW OF CLOSET


SCALE: 1"=1'-0"

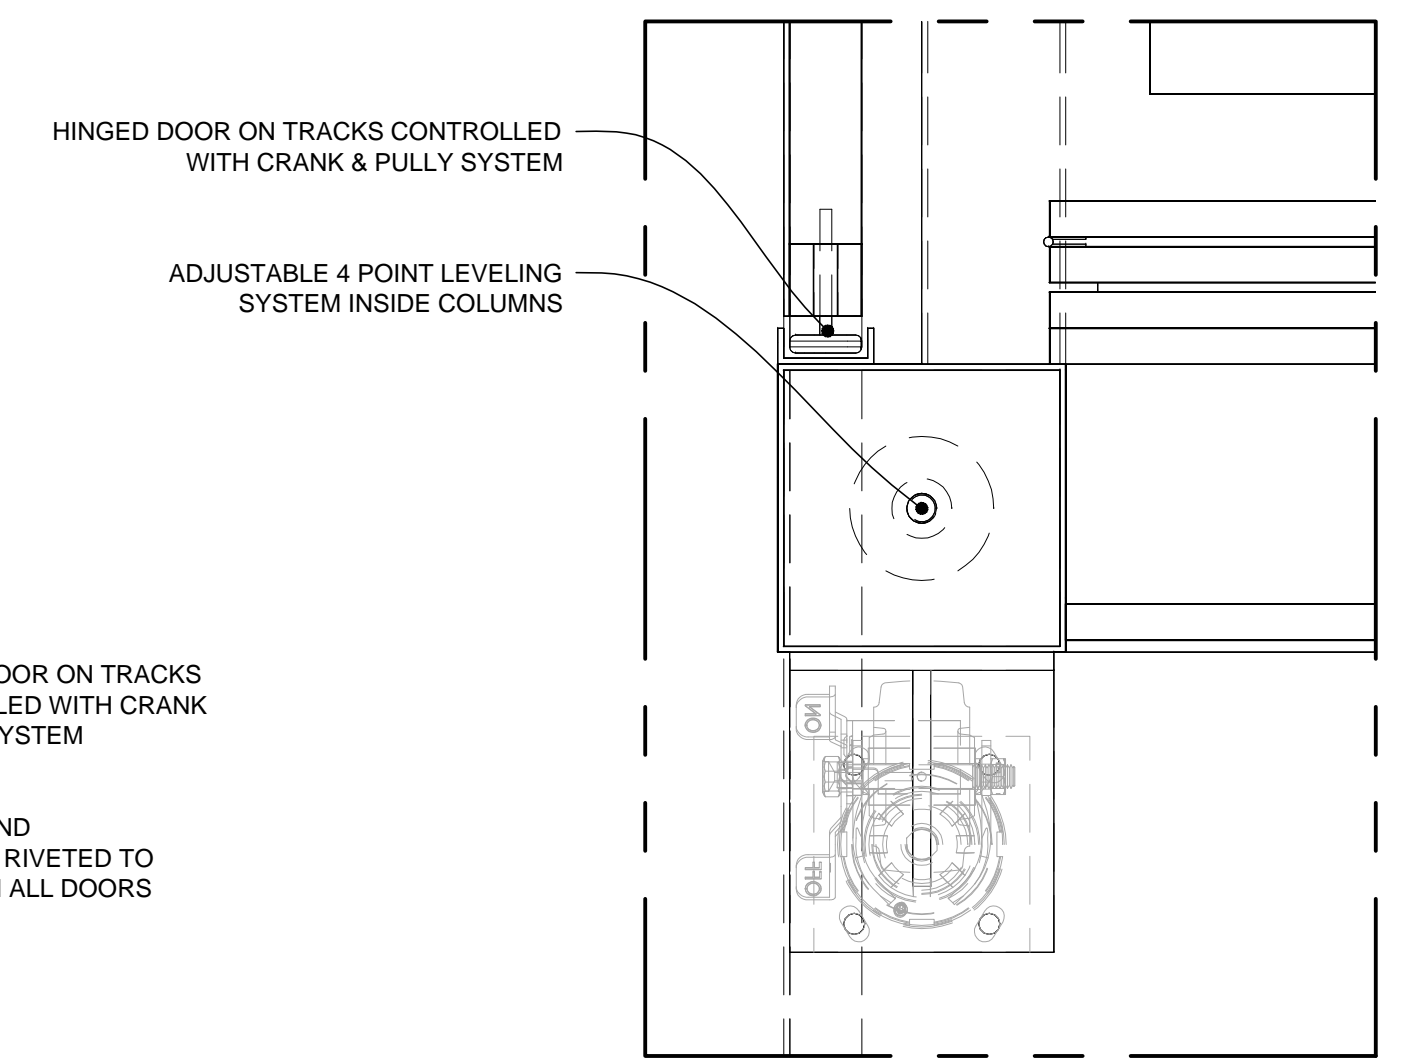

SECTION VIEW

SCALE: 1"=1'-0"


B
2.0

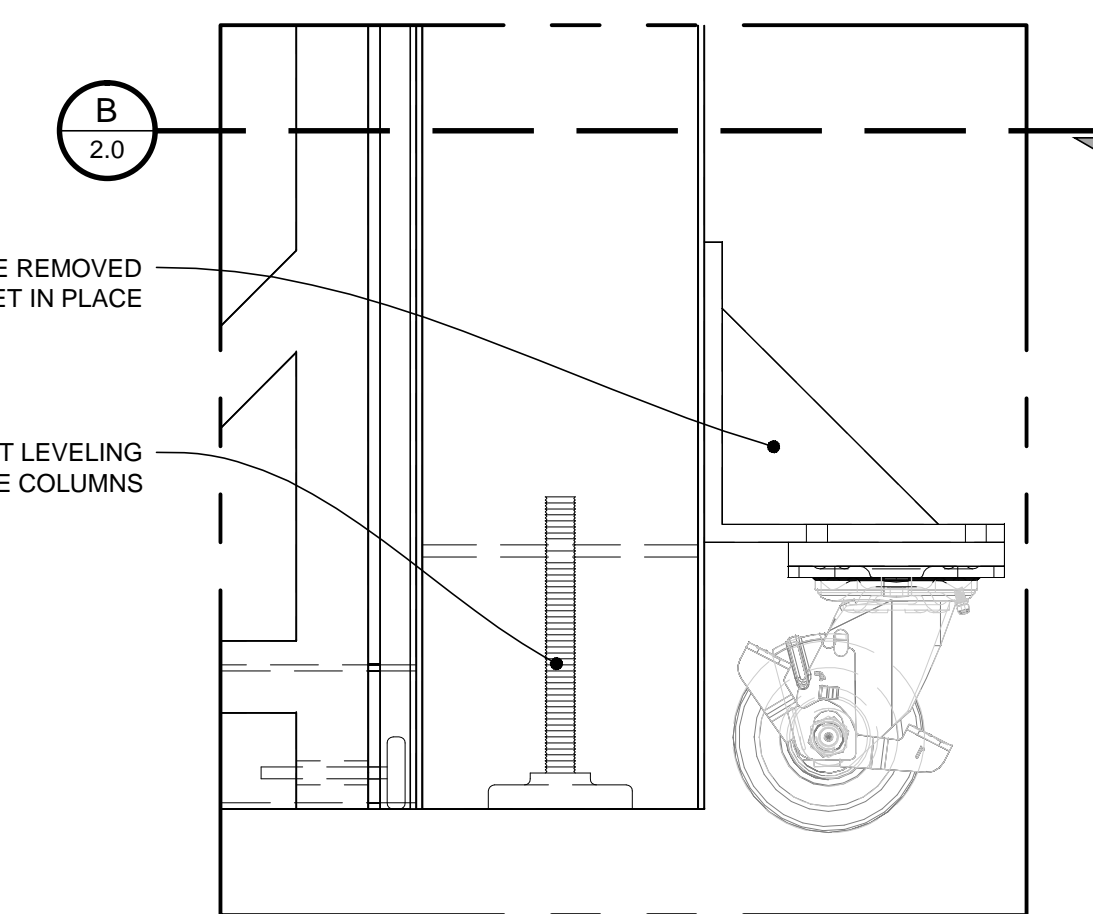

SECTION VIEW


SCALE: 1"=1'-0"

C
2.0

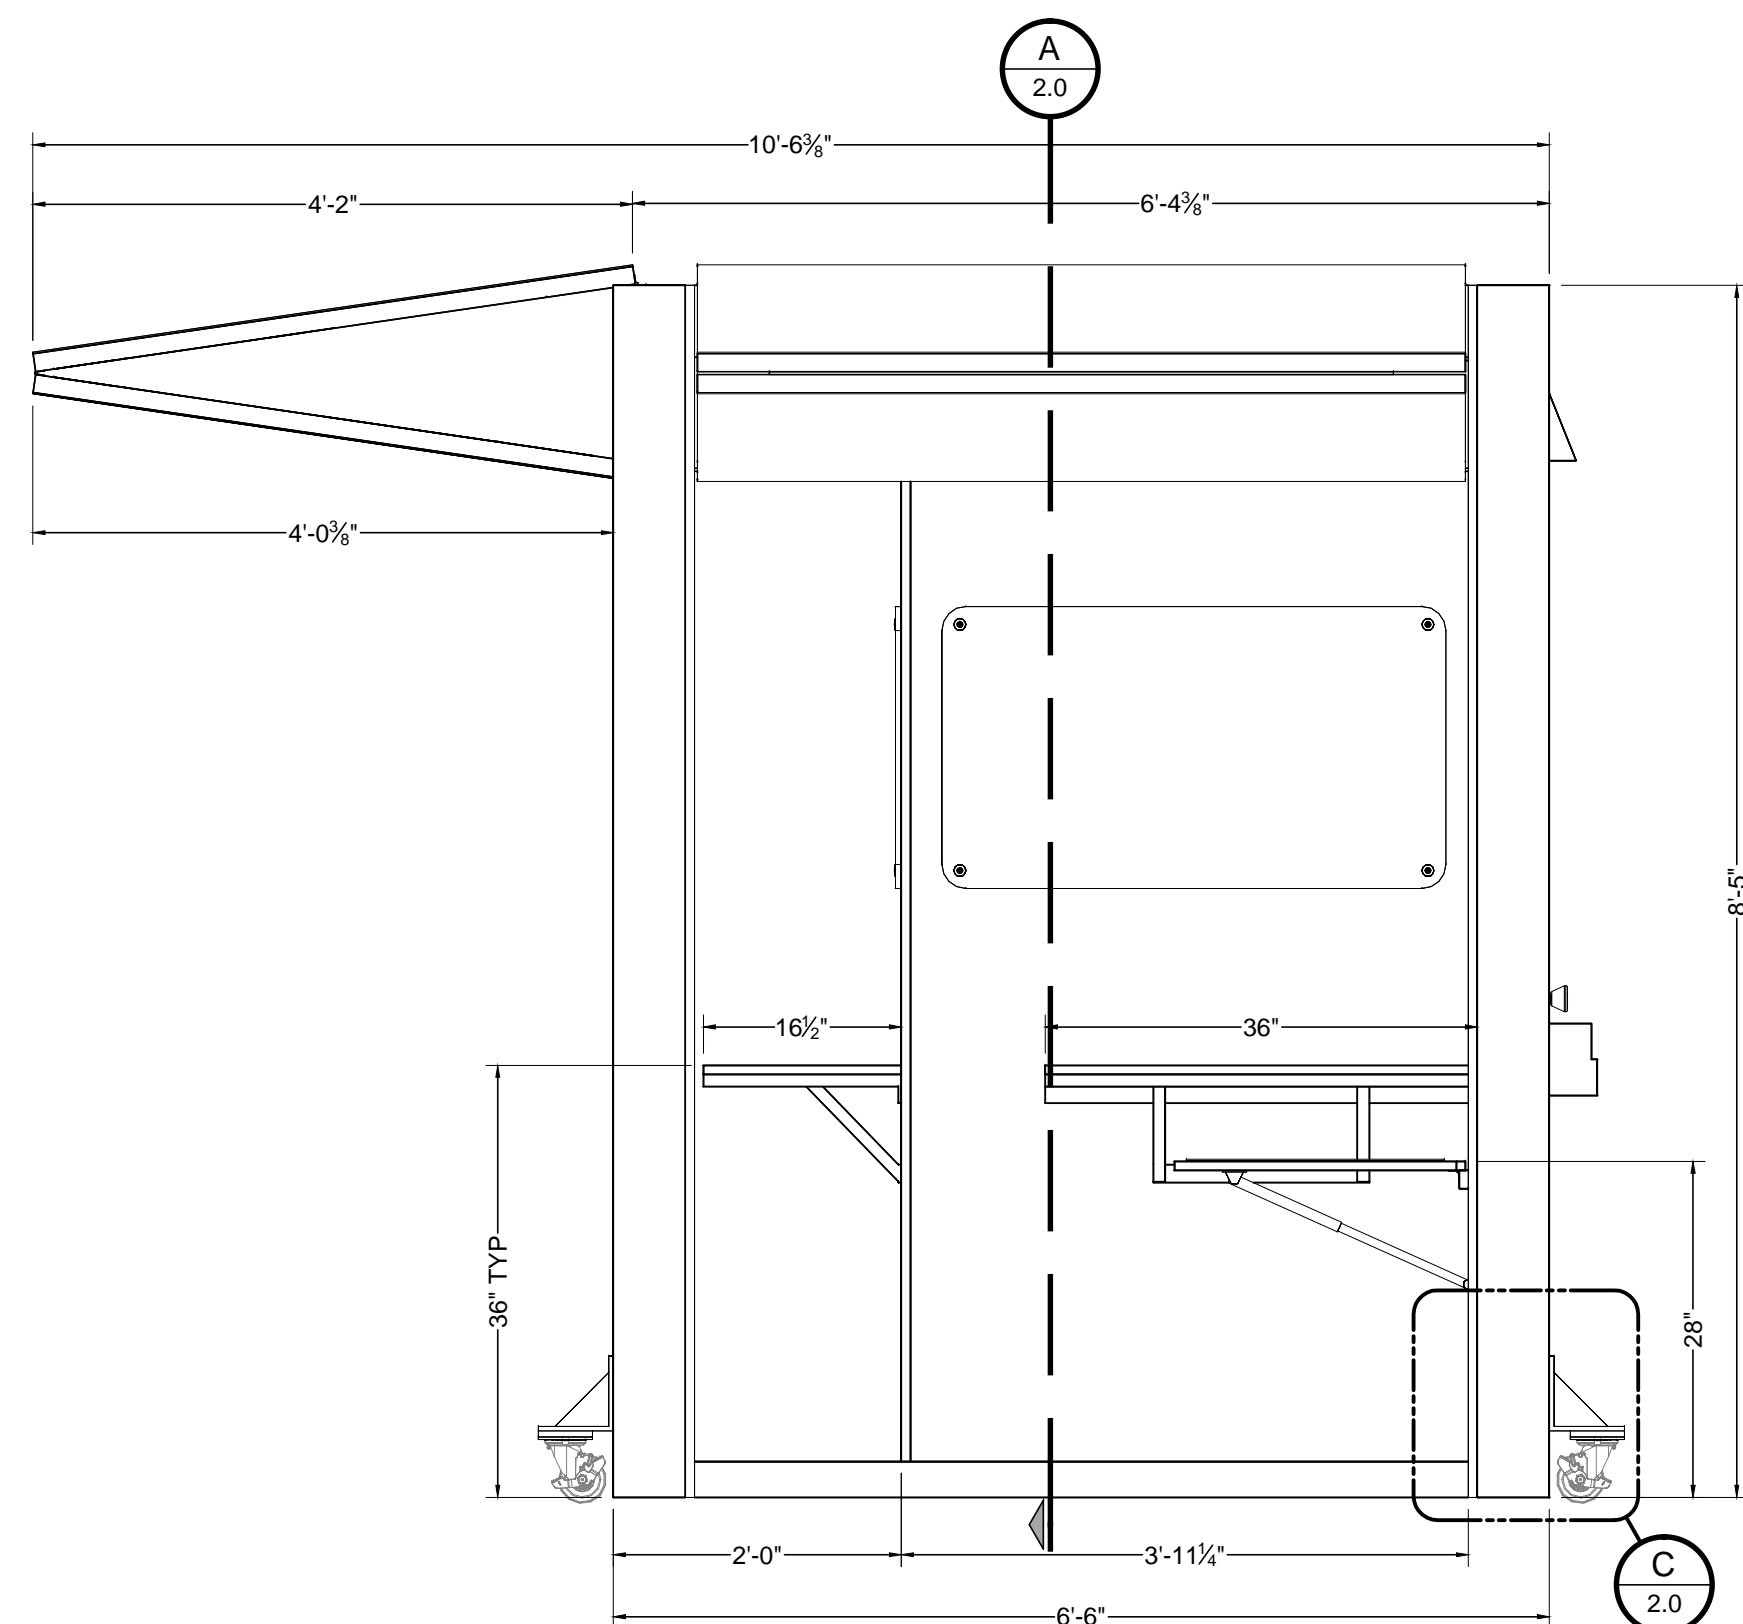


SIDE ELEVATION

SCALE: 3/4" = 1'-0"

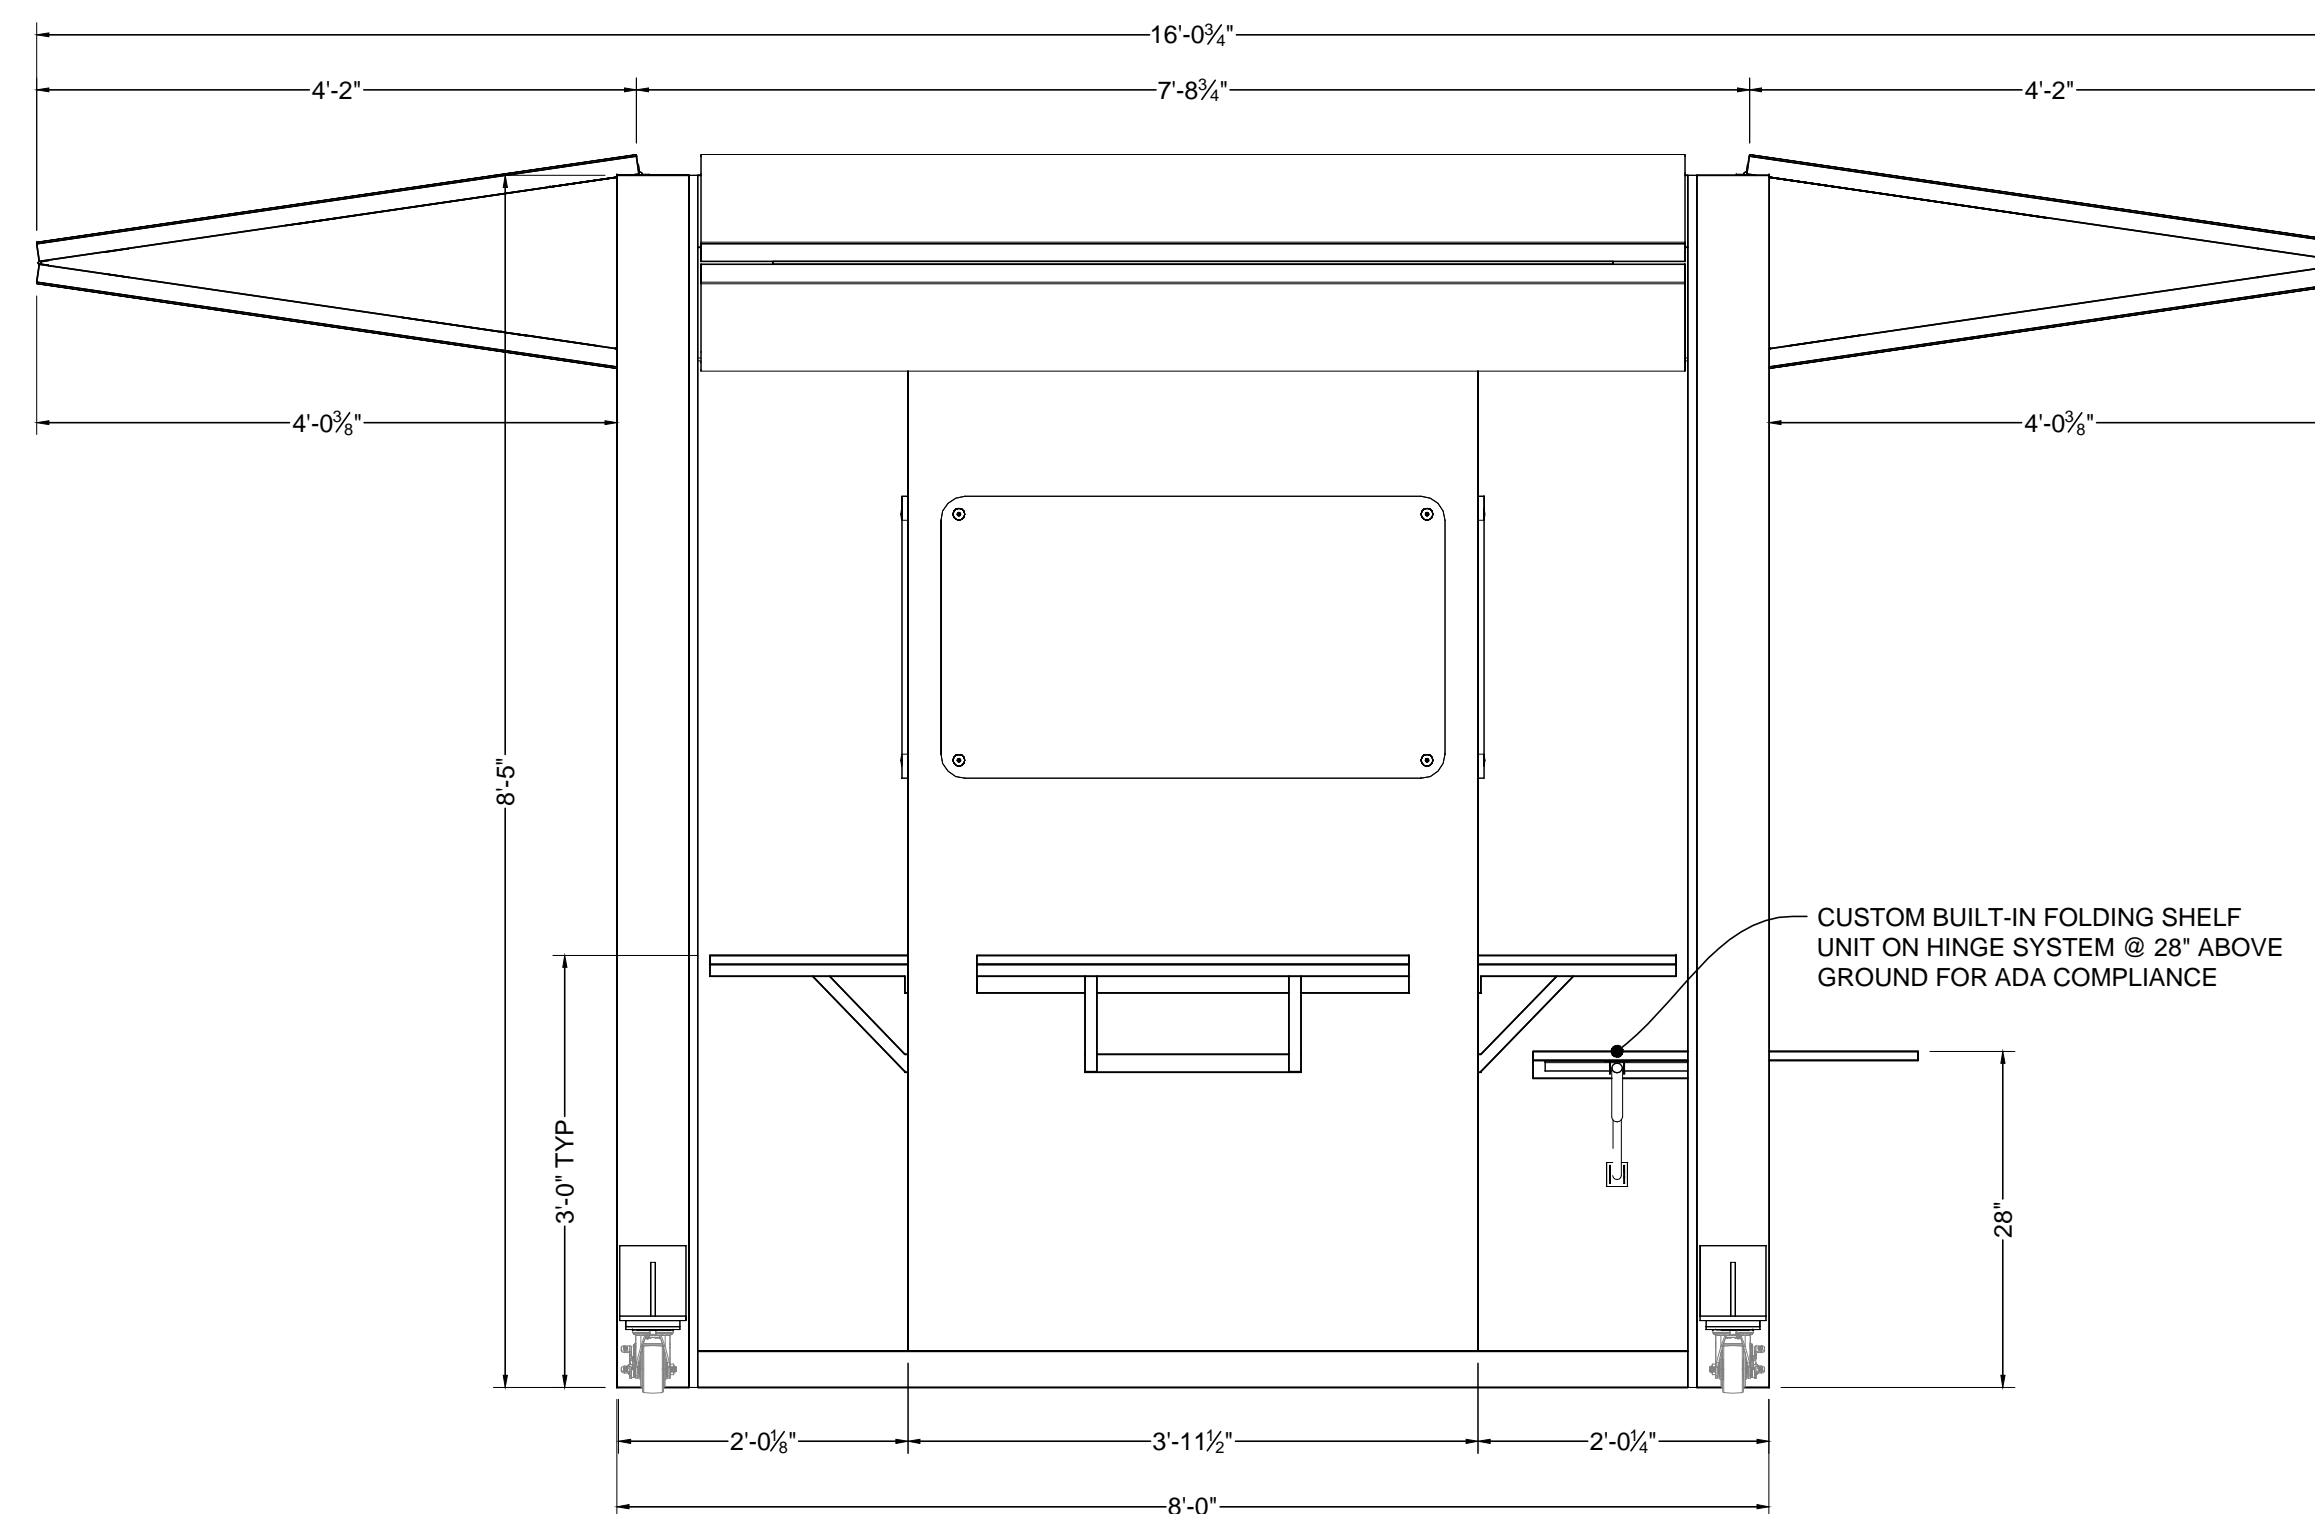

SIDE ELEVATION

SCALE: 3/4" = 1'-0"

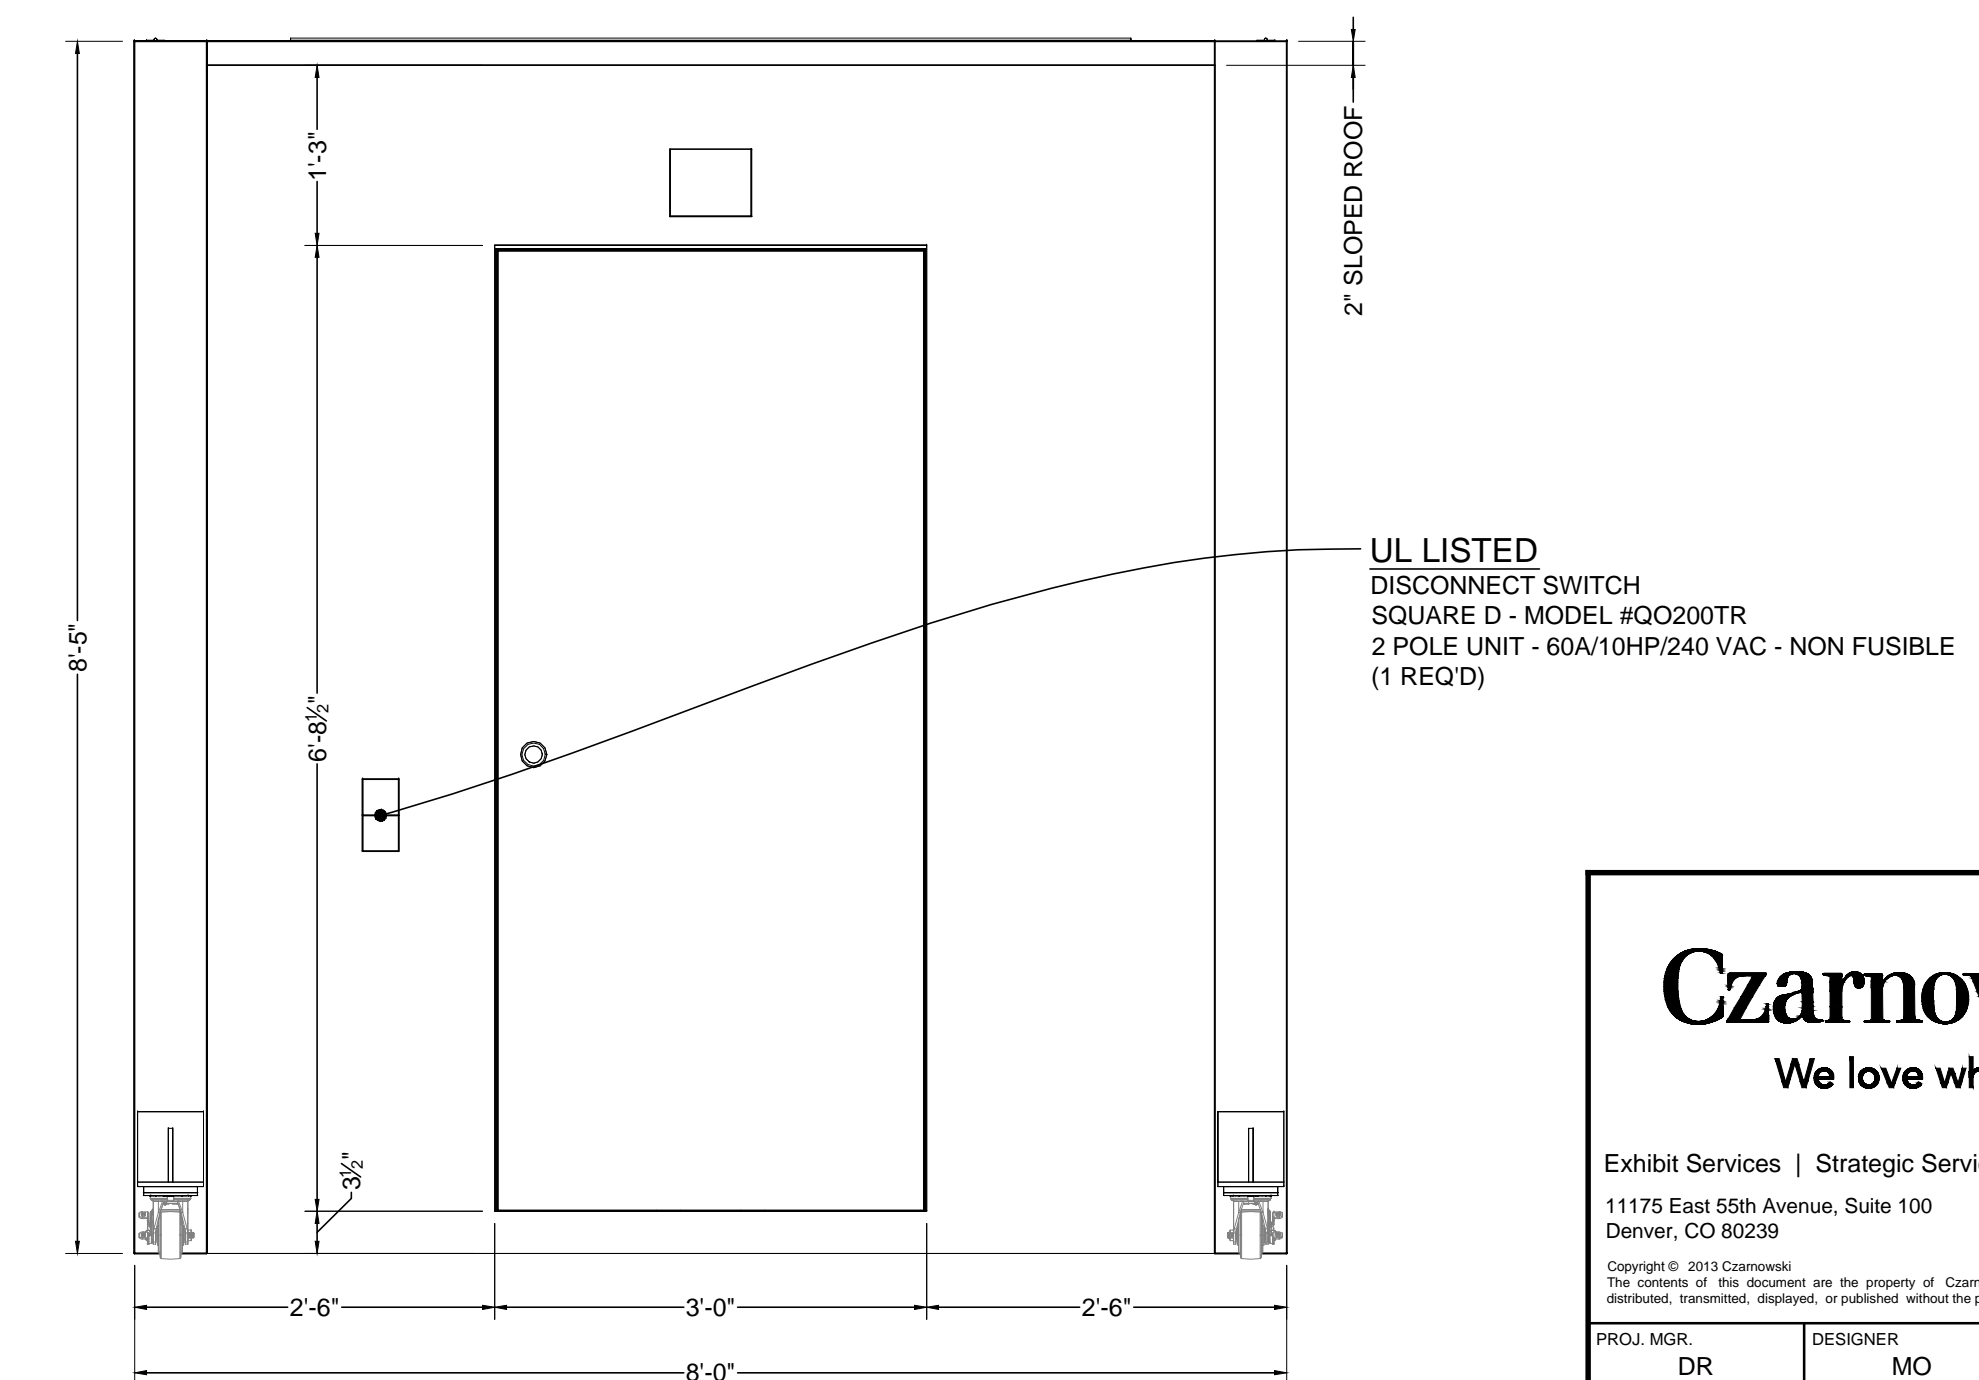

REAR ELEVATION

SCALE: 3/4" = 1'-0"

Czarnowski
We love what we do.

Exhibit Services | Strategic Services | Event Services
11175 East 55th Avenue, Suite 100 Phone: 303.371.3344
Denver, CO 80239 Fax: 303.371.3437

Copyright © 2013 Czarnowski
The contents of this document are the property of Czarnowski and may not be reproduced, distributed, transmitted, displayed, or published without the prior written permission of Czarnowski.

PROJ. MGR.	DR	DESIGNER	MO	DETAILER	PDL
CREATION DATE	03.19.2013	ISSUE DATE	-	RELEASE DATE	-

CLIENT NAME
AMERICAN EXPRESS

ELEMENT NAME
UNIVERSAL STUDIOS KIOSK

DRAWING TITLE
KIOSK AS-BUILT DRAWINGS

CLIENT CODE	PROJECT NO.	SHEET
AMEX	130001	2.0