


Contractor must verify all dimensions on site before commencing any work or shop drawings. If this drawing exceeds the quantities taken in any way the Architects are to be informed before the work is initiated. Only figured dimensions to be taken from this drawing. Drawings based on Ordnance Survey and / or existing record drawings - design and drawing content subject to Site Survey, Structural Survey, Site Investigations, Planning and Statutory Requirements and Approvals. Authorised reproduction from Ordnance Survey Map with permission of the Controller of Her Majesty's Stationery Office. Crown Copyright reserved. enjoy design Limited Copyright. This drawing originates from the CAD file:

Rev	Description	By	Date	Ch

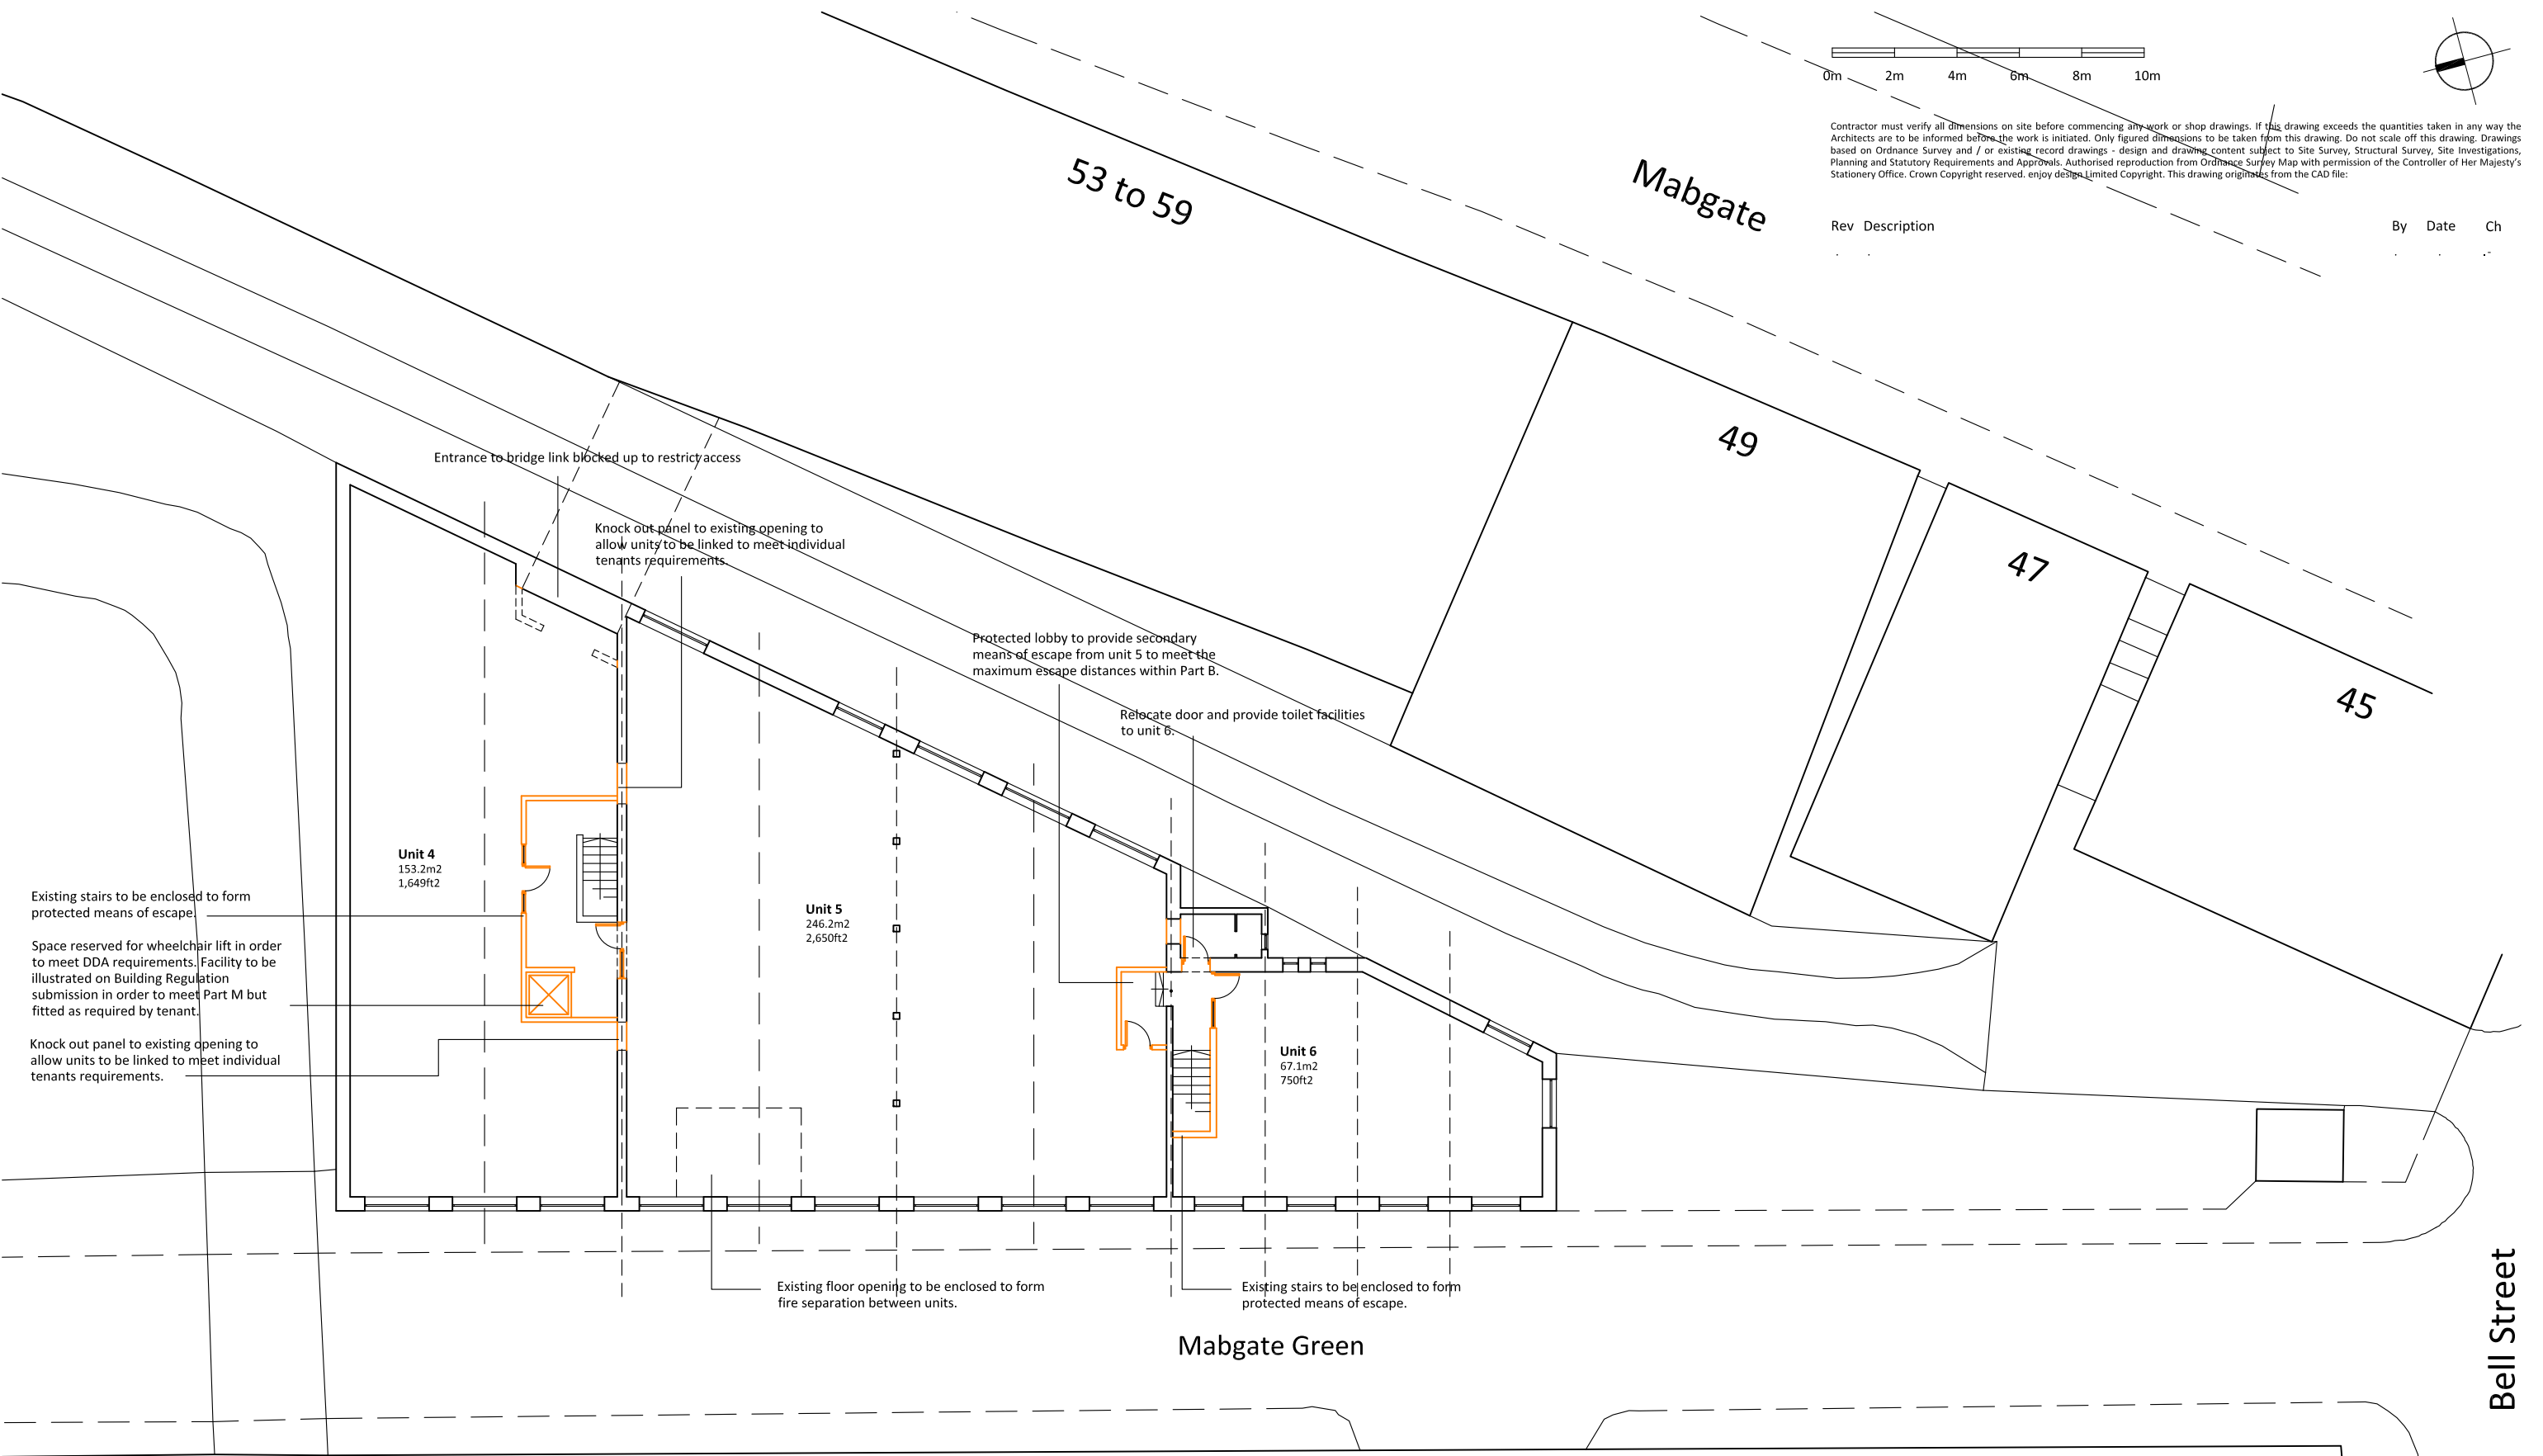

Existing stairs to be enclosed to form protected means of escape.

Space reserved for wheelchair lift in order to meet DDA requirements. Facility to be illustrated on Building Regulation submission in order to meet Part M but fitted as required by tenant.

Knock out panel to existing opening to allow units to be linked to meet individual tenants requirements.

Existing floor opening to be enclosed to form fire separation between units.

Existing stairs to be enclosed to form protected means of escape.

# 37-38 Mabgate Green, Leeds

Scale - 1:200 @ A3

## Regent House

Title: 37-38 Mabgate Green, Leeds	Job No. 11,023
Drawing: First Floor	
Scale: 1:200 @ A3	Drawn by: GM
Date: June '11	Checked by: GM
Drawing No.: 004	Revision No.: 

**Enjoy Design** ARCHITECTURE & MASTERPLANNING

Riverside West  
Whitehall Road  
Leeds  
LS1 4AW

Tel +(44) 773 301 8368  
www.enjoy-design.co.uk

Bell Street

FEASIBILITY