


# SPLIT TEE / HALF SHELL TEE

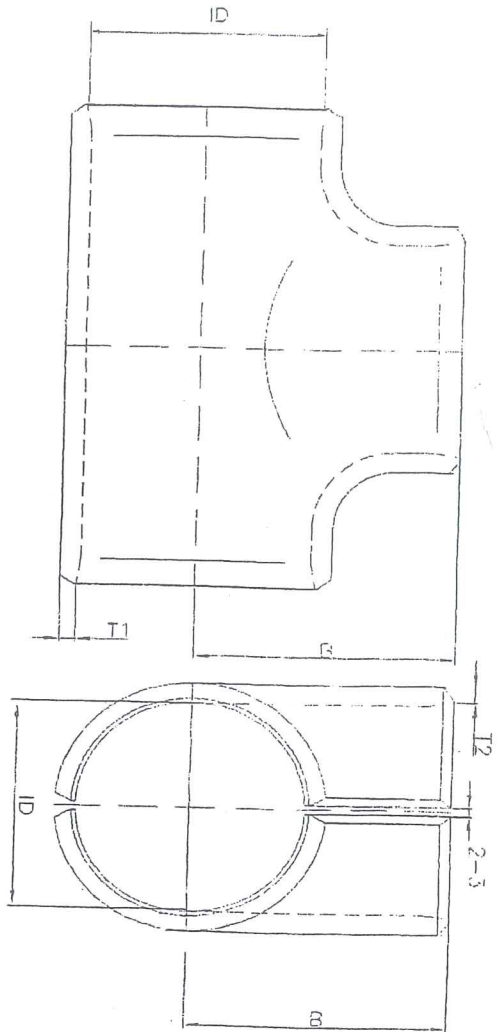

HALF SHELL TEE				
ITEM	ID	T <sub>2</sub>	B	KDC
	<del>168.30</del>	<del>7.41</del>	7.41	143.00
				A234 WPB

OD    TF    ID  
 168.3    7.11    154.08

**NOTES:**

1. ALL DIMENSIONS ARE IN mm UNLESS SPECIFIED.

REV. NO.	DESCRIPTION FOR REVISION	REV. BY	DATE
R1		RAKESH	15/09/14

**DYNAMIC FORGE**

DRN. BY: RAKESH	13/6/2014	TITLE :- Split Tee Buttweld	
CHD. BY: ZUBRAG	13/6/2014		
APPD. BY:	13/6/2014		
SCALE: NTS	SIGN:	DATE:	DRG. NO. :- DIPL-4835-01